

STATE OF KANSAS
STATE CORPORATION COMMISSION


WELL PLUGGING RECORD

OR
FORMATION PLUGGING RECORD

Strike out upper line
when reporting plug-
ging off formations.

Give All Information Completely
Make Required Affidavit
Mail or Deliver Report to:
Conservation Division
State Corporation Commission
800 Blitt Building
Wichita, Kansas

Rice County. Sec. 8 Twp. 21S Rge. 7 (E) 7 (W)
Location as "NE1/4NW1/4SW1/4" or footage from lines. NW/4- NE/4- NW/4
Lease Owner. The Atlantic Refining Company
Lease Name. Gossman "B" Well No. 1
Office Address. P.O. Box 17, Great Bend, Kansas
Character of Well (completed as Oil, Gas or Dry Hole). Oil
Date well completed. April 8, 19 37
Application for plugging filed. April 10, 19 46
Application for plugging approved. April 12, 19 46
Plugging commenced. June 10, 19 46
Plugging completed. June 21, 19 46
Reason for abandonment of well or producing formation. Depleted Formation

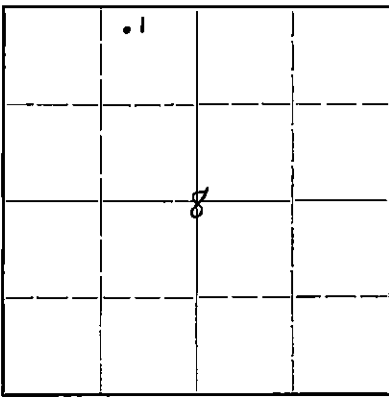

Locate well correctly on above
Section Plat

If a producing well is abandoned, date of last production. January 16, 19 46
Was permission obtained from the Conservation Division or its agents before plugging was com-
menced? Yes

Name of Conservation Agent who supervised plugging of this well. Ruel Durkee
Producing formation. Conglomerate Depth to top. 3330 Bottom. 3339 Total Depth of Well. 3339 Feet
Show depth and thickness of all water, oil and gas formations.


OIL, GAS OR WATER RECORDS

CASING RECORD

Formation	Content	From	To	Size	Put In	Pulled Out
Conglomerate	Gas & Oil	3330	3339	10" 7" O.D.	111' 3326'	None 2696'

Describe in detail the manner in which the well was plugged, indicating where the mud fluid was placed and the method or methods used in introducing it into the hole. If cement or other plugs were used, state the character of same and depth placed, from.....feet to.....feet for each plug set.

Gravel from 3339' to 3326'.
Cement from 3326' to 3297'.
Mud from 3297' to 150'.
Cement from 150' to 100'.
Mud from 110' to 5'.
Cement from 5' to surface.

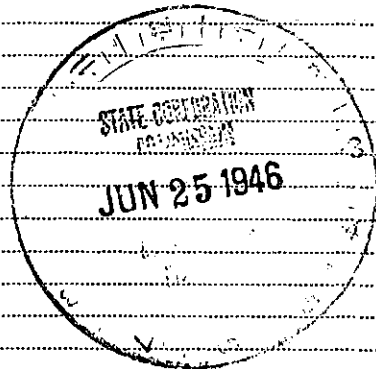

(If additional description is necessary, use BACK of this sheet)

Correspondence regarding this well should be addressed to. The Atlantic Refining Company
Address. P.O. Box 17, Great Bend, Kansas

STATE OF Kansas, COUNTY OF Barton, ss.
Stanton K. Myers (employee of owner) or (owner or operator) of the above-described well,
being first duly sworn on oath, says: That I have knowledge of the facts, statements, and matters herein contained and the log of the above-described well as filed and that the same are true and correct. So help me God.

(Signature) Stanton K. Myers
(Address)

SUBSCRIBED AND SWORN to before me this 24th day of June, 19 46

My commission expires. October 28, 1948
H. C. Colegrove Notary Public.

WELL RECORD

15.159.05332.0000

Block or Twp. 21S

Lease Gossman
Lease No. KS-5996
County Rice

Well No. B-1
State Kansas

Location NW NE NW,
8-21S-7W
Elevation Feet

Drilled { Contract
Company Tools

Contracted Depth
Completed Depth

Feet Date { Started 3-15-37
Completed 4-8-37
Deepened
Cleaned Out

Name of Contractor Reading & Bates

Contract Price 3.35 Per Foot

Well Estimated Cost
Well Actual Cost

Day Work Rotary Tools - \$160 per day
Cable Tools - \$ 90 per day
Method of Drilling Rotary with
Cable tool completion.

BEFORE SHOOTING

AFTER SHOOTING

Initial Production
Settled Production

Flowing
on Pump

Initial Production
Settled Production

Flowing
on Pump

Baume Test

Water With Oil %

Casing Record			Torpedo Record					
SIZE	SET	PULLED	Date Company	From	To	Feet	Size of Shell	Total Qts.
10"	111'	none						
7"	3326'	none						

<u>FORMATION</u>	<u>TOP</u>	<u>BOTTOM</u>	<u>FORMATION</u>	<u>TOP</u>	<u>BOTTOM</u>
Surface clay	0	100	Lime and shale	2210	2275
Redbed	100	110	Shale	2275	2295
Redbed shale & shells	190	230	Lime and shale	2295	2335
Redbed	230	425	Lime	2335	2350
Shale & lime shells	425	465	Shale and shells	2350	2390
Shale and redbed	465	475	Redbed	2390	2405
Redbed	475	490	Shale and shells	2405	2435
Shale	490	600	Shale	2435	2450
Shale and shells	600	670	Lime	2450	2715
Redrock and shale	670	695	Lime and shale	2715	2740
Shale and shells	695	760	Lime	2740	2820
Shale	760	800	Shale	2820	2880
Salt and shale	800	975	Lime and shale	2880	2905
Shale and shells	975	1005	Shale	2905	2925
Shale and lime	1005	1025	Shale and lime	2925	2945
Sandy lime	1025	1045	Lime	2945	3170
Lime shale	1045	1070	Lime and shale	3170	3198
Lime	1070	1190	Lime	3198	3255
Shale and lime	1190	1225	Shale lime and shells	3255	3325
Sandy shale & lime	1225	1275	Coring	3325	3332
Lime and shale	1275	1345	Sandy conglomerate	3330	3331
Lime	1345	1435	Ran 108 Qts. 9' of 20# 7" casing cemented at 3326		
Lime and shale	1435	1480	Cement	3326	3327
Lime	1480	1530	Chert and lime	3327	3333
Lime and shale	1530	1655	Conglomerate	3338	3339 T.D.
Redbed	1655	1685			
Lime	1685	1715			
Shale and lime	1715	1798			
Shale and shells	1798	1825			
Shale and lime	1825	1880			
Shale	1880	1965			
Shale and shells	1965	2115			
Shale and lime	2115	2190			
Redbed	2190	2210			

APR 11 1946

8 21 24
49 36