

STATE OF KANSAS
STATE CORPORATION COMMISSION


WELL PLUGGING RECORD

Give All Information Completely
Make Required Affidavit
Mail or Deliver Report to:
Conservation Division
State Corporation Commission
800 Bitting Building
Wichita, Kansas

OR
FORMATION PLUGGING RECORD

Strike out upper line
when reporting plug-
ging of formations.

NORTH

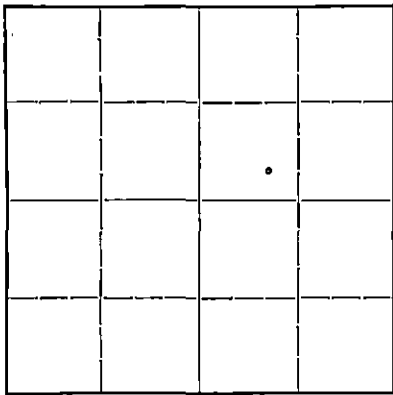

Locate well correctly on above
Section Plat

Rice County, Sec. 8 Twp. 21S Rge. (E) 7 (W)

Location as "NE $\frac{1}{4}$ NW $\frac{1}{4}$ SW $\frac{1}{4}$ " or footage from lines Center SE SW NE

Lease Owner Gulf Oil Corporation

Lease Name M. Gossman Well No. 2

Office Address Box 661, Tulsa, Oklahoma

Character of Well (completed as Oil, Gas or Dry Hole) Oil well

Date, well completed 9-16-37 19

Application for plugging filed 6-19-41 19

Application for plugging approved 6-19-41 19

Plugging Commenced 6-20-41 19

Plugging Completed 6-27-41 19

Reason for abandonment of well or producing formation Production declined to where
was unprofitable to produce.

If a producing well is abandoned, date of last production March 10, 1941 19

Was permission obtained from the Conservation Division or its agents before plugging was com-
menced? Yes

Name of Conservation Agent who supervised plugging of this well Ruel Durkee, McPherson, Kansas

Producing formation Conglomerate Depth to top 3331' Bottom Total Depth of Well 3358 Feet

Show depth and thickness of all water, oil and gas formations.


OIL, GAS OR WATER RECORDS

CASING RECORD

Formation	Content	From	To	Size	Put In	Pulled Out
				10-3/4"	162'	None
				7"	3325'	2584'

Describe in detail the manner in which the well was plugged, indicating where the mud fluid was placed and the method or methods used in introducing it into the hole. If cement or other plugs were used, state the character of same and depth placed, from _____ feet to _____ feet for each plug set.

Mudded hole from 3358' to 3344'. Dumped 10 sacks of cement 3344' to 3274'. Mudded hole to 2900', ripped 7" casing at 2550', recovered 83 jts and one nipple. Mudded hole to 205', placed rock bridge and plug from 205' to 200', dumped 12 sacks cement from 200' to 175'. Mudded to 14', placed plug and bridge and capped with 8 sacks cement.

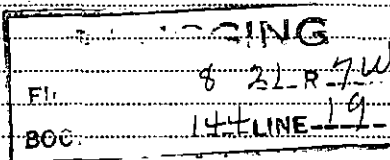

(If additional description is necessary, use BACK of this sheet)

Correspondence regarding this well should be addressed to Gulf Oil Corporation

Address Box 661, Tulsa, Oklahoma

7-10-1941

STATE OF Kansas, COUNTY OF Rice, ss. O. L. Stevenson (employee of owner) or (owner or operator) of the above-described well,

being first duly sworn on oath, says: That I have knowledge of the facts, statements, and matters herein contained and the log of the above-described well as filed and that the same are true and correct. So help me God.

(Signature) O. L. Stevenson

(Address)

SUBSCRIBED AND SWORN to before me this 8th day of July, 1941

Jackson E. Watkins Notary Public.

My commission expires January 3, 1945



