

15-097-10199-0000

STATE OF KANSAS  
STATE CORPORATION COMMISSION


Form CP-4

WELL PLUGGING RECORD

Give All Information Completely  
Make Required Affidavit  
Mail or Deliver Report to:  
Conservation Division  
State Corporation Commission  
211 No. Broadway  
Wichita, Kansas

Kiowa County. Sec. 23 Twp. 30S Rge. 1(E) 19 (W)  
Location as "NE/CNW&SW&" or footage from lines C NE/4 NW/4  
Lease Owner Graham-Michaelis Drilling, Inc.  
Lease Name Hayse Well No. 1-23  
Office Address 211 North Broadway, Wichita, Kansas 67202  
Character of Well (completed as Oil, Gas or Dry Hole) Dry Hole  
Date well completed November 8, 19 66  
Application for plugging filed November 8, 19 66  
Application for plugging approved (verbal) November 8, 19 66  
Plugging commenced November 8, 19 66  
Plugging completed November 8, 19 66  
Reason for abandonment of well or producing formation Dry Hole

NORTH

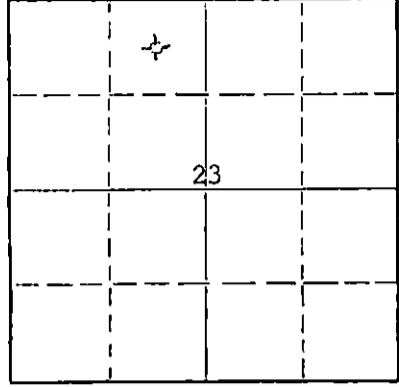

Locate well correctly on above  
Section Plat

If a producing well is abandoned, date of last production \_\_\_\_\_ 19\_\_\_\_  
Was permission obtained from the Conservation Division or its agents before plugging was commenced? yes (verbal)

Name of Conservation Agent who supervised plugging of this well Archie V. Elving, Pratt, Kansas  
Producing formation none Depth to top \_\_\_\_\_ Bottom \_\_\_\_\_ Total Depth of Well 5165' Feet  
Show depth and thickness of all water, oil and gas formations.

OIL, GAS OR WATER RECORDS

CASING RECORD

FORMATION	CONTENT	FROM	TO	SIZE	PUT IN	PULLED OUT
				8 5/8"	406'	none

Describe in detail the manner in which the well was plugged, indicating where the mud fluid was placed and the method or methods used in introducing it into the hole. If cement or other plugs were used, state the character of same and depth placed, from \_\_\_\_\_ feet to \_\_\_\_\_ feet for each plug set.

Dumped 35 sx cement at T.D., 5165', filled with heavy drilling mud, 25 sx cement at 400', filled with heavy drilling mud and 10 sax at 40'- plug at top of surface casing below plow level.

RECEIVED  
STATE CORPORATION COMMISSION

NOV 28 1966

CONSERVATION DIVISION  
Wichita, Kansas

(If additional description is necessary, use BACK of this sheet)

Name of Plugging Contractor Graham-Michaelis Drilling, Inc.  
Address 211 North Broadway, Wichita, Kansas 67202

STATE OF Kansas, COUNTY OF Sedgwick, ss.  
John L. James (employee of owner) or (XXXXXX) of the above-described well, being first duly sworn on oath, says: That I have knowledge of the facts, statements, and matters herein contained and the log of the above-described well as filed and that the same are true and correct. So help me God.

(Signature) John L. James John L. James  
211 North Broadway, Wichita, Kansas 67202  
(Address)

SUBSCRIBED AND SWORN TO before me this 14th day of November, 19 66

My commission expires December 12, 1966

Evelyn P. Evans  
Evelyn P. Evans Notary Public.

HAYSE NO. 1-23

15-097-10199-0000

WELL RECORD:

LOCATION:

C NE NW Section 23-30S-19W  
Kiowa County, Kansas

Commenced: 10-27-66  
Completed: 11-8-66  
(Rotary)

CONTRACTOR:

Graham-Michaelis Drilling, Inc.  
Liberal Division  
P. O. Box 1294  
Liberal, Kansas 67901

CASING RECORD:

13 Joints 8-5/8" 2 1/4" Casing  
Cemented w/300 sx Sunset

	<u>LOG</u>
Surface Sand & Red Bed	0 - 508
Red Bed, Sand & Gyp	508 - 1185
Red Bed, Gyp, Sand & Shale	1185 - 1747
Lime & Shale	1747 - 4661
Lime	4661 - 4723
Lime & Shale	4723 - 4982
Cherty Lime & Shale	4982 - 5102
Lime	5102 - 5165

5165' - Total Rotary Depth

The undersigned, Graham-Michaelis Drilling, Inc., Liberal Division, certifies that the above log is a true and correct copy of the formations encountered in drilling the above mentioned well, as taken from the Daily Drilling Report.

GRAHAM-MICHAELIS DRILLING, INC.  
LIBERAL DIVISION

By   
H. R. Michaelis

RECEIVED  
STATE CORPORATION COMMISSION  
NOV 28 1966  
CONSERVATION DIVISION  
Wichita, Kansas