


STATE OF KANSAS
STATE CORPORATION COMMISSION

Give All Information Completely
Make Required Affidavit
Mail or Deliver Report to:
Conservation Division,
State Corporation Commission
217 No. Market
Wichita, Kansas 67202

WELL PLUGGING RECORD

NORTH

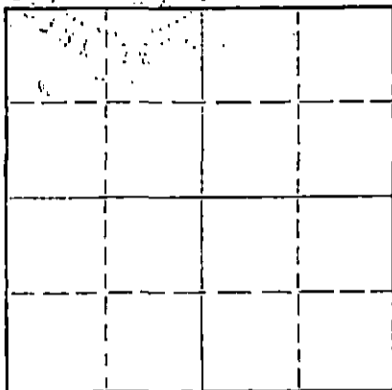

Locate well correctly on above
Section Plat

Rice County, Sec. 12 Twp. 21S Rge. 7W (E) (W)
Location as "NE/CNW%SW%" or footage from lines. NE/4 SE/4 SW/4
Lease Owner Simon Lebow Corp.
Lease Name Pallister Well No. 2
Office Address 1521 Thompson Bldg., Tulsa, Oklahoma
Character of Well (completed as Oil, Gas or Dry Hole) Oil Well
Date well completed 19
Application for plugging filed Feb. 19 1971
Application for plugging approved Feb. 20 19 71
Plugging commenced Mar. 29 19 71
Plugging completed Mar. 29 19 71
Reason for abandonment of well or producing formation

If a producing well is abandoned, date of last production 19
Was permission obtained from the Conservation Division or its agents before plugging was commenced? Yes

Name of Conservation Agent who supervised plugging of this well Gilbert Toman
Producing formation Depth to top Bottom Total Depth of Well Feet
Show depth and thickness of all water, oil and gas formations.

OIL, GAS OR WATER RECORDS

CASING RECORD

FORMATION	CONTENT	FROM	TO	SIZE	PUT IN	PULLED OUT

Describe in detail the manner in which the well was plugged, indicating where the mud fluid was placed and the method or methods used in introducing it into the hole. If cement or other plugs were used, state the character of same and depth placed, from feet to feet for each plug set.

Used shot at 200' and squeezed with Halliburton with 100 sacks of cement.

RECEIVED
STATE CORPORATION COMMISSION
APR 8 1971
CONSERVATION DIVISION
Wichita, Kansas

Name of Plugging Contractor Bert Self
Address Hutchinson, Kans.

STATE OF Kansas, COUNTY OF Reno, ss.
Employee (employee of owner) or (owner or operator) of the above-described

well, being first duly sworn on oath, says: That I have knowledge of the facts, statements, and matters herein contained and the log of the above-described well as filed and that the same are true and correct. So help me God.

(Signature) Bert Self
R. R. #4, Hutchinson, Kans. 67501
(Address)

Subscribed and sworn to before me this 30th day of March, 1971



Dorothy Self
Notary Public.


My commission expires October 18, 1973

KIRK D. HOLLAND
Pallister No. 2

SEC. 12 T. 21 R. 7 W.
NE SE SW

Total Depth 3439
Comm. 9-14-41 Comp. 10-7-41
Shot or Treated.
Contractor. Ingling and Parker.
Issued. 3-21-42

County Rice.

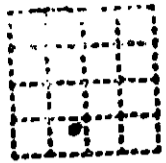

CASING.

85/8" 100'
5 1/2" 3426'

Elevation.

Production. Pot. 200 B.

Figures Indicate Bottom of Formations.

sand and clay	90
red bed	240
red bed sand&shale	420
sand and shale	665
shale and shells	780
shale and salt	1030
shells and shale	1180
shale and lime	1305
broken lime	1430
shale and lime	1660
shale and shells	1745
shale and lime	1850
shale and shells	2160
shale and lime	2245
shale and shells	2470
lime	2750
shale	2820
lime	2910
lime and shale	2960
lime	3260
shale and lime	3426 T.D. Rotary.
conglomerate	3439
Total Depth.	

Top Conglomerate 3429

RECEIVED
STATE CORPORATION COMMISSION
MAR 8 1971
CONSERVATION DIVISION
Wichita, Kansas