

WELL PLUGGING RECORD
OR
FORMATION PLUGGING RECORD

STATE OF KANSAS
STATE CORPORATION COMMISSION

NORTH


**Locate well correctly on above
Section Plat**

Name of Conservation Agent who supervised plugging of this well..... Rurl Durkee
Producing formation..... Conglomerate Depth to top..... Bottom..... Total Depth of Well 3416 Feet

Show depth and thickness of all water, oil and gas formations.

OIL, GAS OR WATER RECORDS




OIL, GAS OR WATER RECORDS

CASING RECORD

Describe in detail the manner in which the well was plugged, indicating where the mud fluid was placed and the method or methods used in introducing it into the hole. If cement or other plugs were used, state the character of same and depth placed, from.....feet to.....feet for each plug set.

Filled with gravel 75 feet Dumped 6 sacks cement with bailer,
filled hole with mud set bridge at 160 feet placed 125 sacks cement,
filled hole with mud to top and run 5 sacks cement

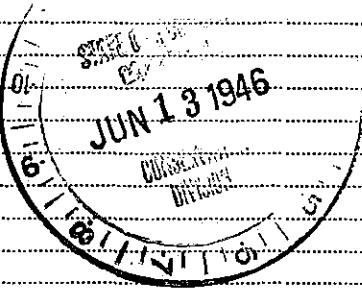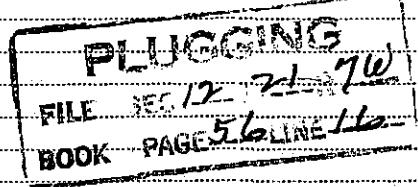

(If additional description is necessary, use BACK of this sheet)

Correspondence regarding this well should be addressed to Great Western Oil Company.
Address 635 18th Street, Denver, Colorado.

Kansas Rice
STATE OF _____, COUNTY OF _____, ss.

..... (employee of owner) or (owner or operator) of the above-described well, being first duly sworn on oath, says: That I have knowledge of the facts, statements, and matters herein contained and the log of the above-described well as filed and that the same are true and correct. So help me God. *R. H. R. G. L.*

(Signature)

Rollin Mlad

Sterling, Kansas

SUBSCRIBED AND SWORN to before me this 12 day of June 1946.

My commission expires 9/17/49

9/17/49

.....
Notary Public.

STERLING DRILLING COMPANY
STERLING, KANSAS

Company - Great Western Oil Co.

Sec. 12 T. 21 R. 7

Farm - Pallister # 1

C NE $\frac{1}{4}$ -SW $\frac{1}{4}$ -SW $\frac{1}{4}$

Total Depth 3396 ft.

County - Rice

Comm. 3/26/46 Comp. 4/7/46

Shot or Treated

Contractor - Sterling Drilling Co.

Elevation -

Casing

10" -- 120 ft.

Production -

Sand	0- 50
Shale & Shells	50- 120
Shales	120- 250
Shale & Shales	250- 650
Salt & Shale	650-1000
Lime & Shale	1000-1470
Lime	1470-1665
Shale & Shells	1665-1825
Shale	1825-2010
Shale & Lime	2010-2130
Shale	2130-2375
Lime	2375-2695
Shale	2695-2785
Shale & Shells	2785-2860
Broken Lime	2860-2915
Lime	2915-3255
Lime & Shale	3255-3364
Shale	3364-3396
Conglomerate	3396-3397

TD - Rotary 3396

The above is a true and correct copy of drilling log on Pallister No. 1, C NE $\frac{1}{4}$ -SW $\frac{1}{4}$ -SW $\frac{1}{4}$, Sec. 12-21-7, Rice County, Kansas.

Sterling Drilling Co.

by H. C. Neuman President

Subscribed and sworn to before me this 8th day of April, 1946.

J. A. Weller

Notary Public.

My term expires September 17th, 1949.

