


STATE OF KANSAS
STATE CORPORATION COMMISSION

Your file 3-23

WELL PLUGGING RECORD

Give All Information Completely
Make Required Affidavit
Mail or Deliver Report to:
Conservation Division
State Corporation Commission
800 Bitting Building
Wichita, Kansas

NORTH

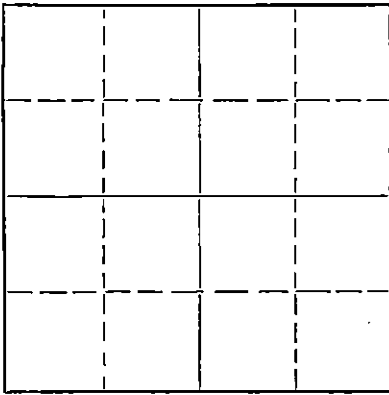

Locate well correctly on above
Section Flat

Rice County. Sec. 12 Twp. 21 Rge. 7W (E) (W)
Location as "NE/CNW 1/4 SW 1/4" or footage from lines NW SW SE 12-21-7W
Lease Owner J. A. DAVIS - J. H. CHILD
Lease Name Pallister Well No. 1
Office Address 121 West Second, Hutchinson, Kansas
Character of Well (completed as Oil, Gas or Dry Hole) Oil
Date well completed 12-30-41 19...
Application for plugging filed 2-25-52 19...
Application for plugging approved 2-25-52 19...
Plugging commenced 3-8-52 19...
Plugging completed 3-15-52 19...
Reason for abandonment of well or producing formation Depleted—uneconomical to operate.
If a producing well is abandoned, date of last production 2-29-52 19...
Was permission obtained from the Conservation Division or its agents before plugging was commenced? Yes

Name of Conservation Agent who supervised plugging of this well Mr. Ruel Durkee, Box 597, McPherson, Kansas
Producing formation Conglomerate Depth to top 3424 Bottom 3441 Total Depth of Well 3441 Feet
Show depth and thickness of all water, oil and gas formations.

OIL, GAS OR WATER RECORDS

CASING RECORD

Table with 7 columns: Formation, Content, From, To, Size, Put In, Pulled Out. The table is currently empty.

Describe in detail the manner in which the well was plugged, indicating where the mud fluid was placed and the method or methods used in introducing it into the hole. If cement or other plugs were used, state the character of same and depth placed, from... feet to... feet for each plug set.

Fill hole with crushed rock from 3441' to 3415'. Run 6 sks. cement from 3415' to 3385'.
Fill with mud from 3385' to 165'. Use rock and bridge solid from 165' to 155'.
Run 20 sks. cement from 155' to 115'. Fill with mud from 115' to 15'. Gap with 5 sks. cement from 15' to cellar. Pull 2936 ft. of 7" csg., surface csg. left in.

3-27-1952


(If additional description is necessary, use BACK of this sheet)
Name of Plugging Contractor Morgan Well Plugging Service
Address Hutchinson, Kansas

STATE OF KANSAS, COUNTY OF RENO, ss.
... (employee of owner) or (owner or operator) of the above-described well,
being first duly sworn on oath, says: That I have knowledge of the facts, statements, and matters herein contained and the log of the above-described well as filed and that the same are true and correct. So help me God.

(Signature) [Signature] for J. A. Davis - J. H. Child
121 West Second, Hutchinson, Kansas
(Address)

SUBSCRIBED AND SWORN to before me this 26th day of March, 1952.

My commission expires 8/30/52 [Signature] Notary Public.

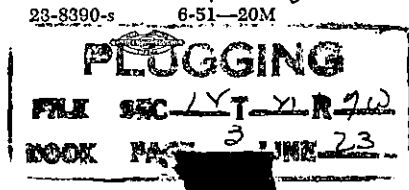

B. F. PALLISTER NEW WEL #1

COMPANY	LOCATION	COUNTY	DRILLING CONTRACTOR
Carl Hipple Oil Co.	NW SW SE Section 12-21-7	Rice	H. M. Williams Drlg. Co.
	DRILLING BEGAN 12-8-41		DRILLING COMPLETED 12-28-41

Soil, sand and shale	100	105' of 10" casing set
Shale & shells	105	
Shale	194	
Shale & shells	970	
Anhydrite	1075	
Broken lime & shale	1180	
Shale & lime shells	1277	
Shale (sticky)	1285	
Sand	1365	
Shale	1397	
Sand	1450	
Sandy lime	1500	
Shale (sticky)	1560	
Hard shale & lime	1600	
Shale & shells	1775	
Lime shells	1835	
Shale & lime	2165	
Shale	2250	
Shale & lime	2315	
Shale & shells	2445	
Shale	2470	
Lime & hard shale	2534	
Broken lime	2607	
Lime & shale	2653	
Lime	2697	
Shale & lime	2912	
Broken lime & shale	2980	
Lime & shale	3039	
Lime	3045	
Lime & shale	3185	
Lime	3304	
Lime & shale	3355	
Lime	3400	
Conglomerate & lime	3424	7" casing set at 3424 - 108 joints
Conglomerate	3441	Cemented with 60 sacks
		20'4" of 5 $\frac{1}{2}$ " OD liner set at 3434
Total depth	3441	Best show of oil 3435 to 3441
		Tube well 12-20-41

