


STATE OF KANSAS  
STATE CORPORATION COMMISSION

Form CP-4

Give All Information Completely  
Make Required Affidavit  
Mail or Deliver Report to:  
Conservation Division  
State Corporation Commission  
212 No. Market  
Wichita, Kansas 67202

WELL PLUGGING RECORD

NORTH

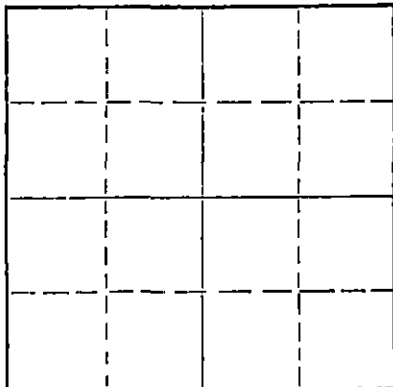

Locate well correctly on above  
Section Plat

Rice County, Sec. 12 Twp. 21 Rge. 7W (E) (W)  
Location as "NE/CNW/SW" or footage from lines NE SE SE  
Lease Owner Northridge Oil Co.  
Lease Name Brothers Well No. I  
Office Address Box 18271 Denver, Colorado  
Character of Well (completed as Oil, Gas or Dry Hole) oil  
Date well completed 8-19 19 53  
Application for plugging filed 10-30 19 71  
Application for plugging approved 11-1 19 71  
Plugging commenced 11-12 19 71  
Plugging completed 11-13 19 71  
Reason for abandonment of well or producing formation

If a producing well is abandoned, date of last production 19  
Was permission obtained from the Conservation Division or its agents before plugging was commenced? Yes

Name of Conservation Agent who supervised plugging of this well Gilbert Toman  
Producing formation Depth to top Bottom Total Depth of Well 3473' Feet  
Show depth and thickness of all water, oil and gas formations.

OIL, GAS OR WATER RECORDS

CASING RECORD

FORMATION	CONTENT	FROM	TO	SIZE	PUT IN	PULLED OUT
				5 1/2"		I, 349'

Describe in detail the manner in which the well was plugged, indicating where the mud fluid was placed and the method or methods used in introducing it into the hole. If cement or other plugs were used, state the character of same and depth placed, from feet to feet for each plug set.

Plugged off bottom of hole with sand. Sand from 3473' to 3460'. Dumped 5 sx of cement. Mudded hole to 210'. Made 10' of rock bridge. Dumped 35 sx of cement. Mudded hole to 40'. Made 10' of rock bridge. Dumped 10 sx of cement, filling to the bottom of the collar.

RECEIVED  
STATE CORPORATION COMMISSION  
NOV 15 1971  
CONSERVATION DIVISION  
Wichita, Kansas

(If additional description is necessary, use BACK of this sheet)  
Name of Plugging Contractor: Art Lamb Casing Pulling Co.  
Address: 2809 King St. Hutchinson, Kansas 67501

STATE OF Kansas, COUNTY OF Reno, ss,  
Art Lamb (employee of owner) or (owner or operator) of the above-described well, being first duly sworn on oath, says: That I have knowledge of the facts, statements, and matters herein contained and the log of the above-described well as filed and that the same are true and correct. So help me God.

(Signature) Art Lamb  
2809 King St. Hutchinson, Kansas 67501  
(Address)

SUBSCRIBED AND SWORN TO before me this 13th day of November, 1971

My commission expires January 5, 1974

Judy Lamb  
Notary Public

COPY

WELL LOG BUREAU—KANSAS GEOLOGICAL SOCIETY  
508 East Murdock, Wichita, Kansas


15.159.05410.0000

Company- H. C. BENNETT  
Farm- Brothers No. 1

SEC. 12 T. 21 R. 7W  
NE SE SE

Total Depth. 3473'  
Comm. 7-31-53 Comp. 8-19-53  
Shot or Treated.  
Contractor.  
Issued. 3-4-61

County Rice KANSAS

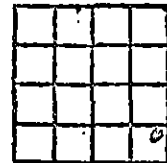

CASING:  
5" 3471'

Elevation. 1659' DF

Production. 29.80 & 110 BW

Figures Indicate Bottom of Formations.

COMPLETE DRILLERS LOG NOT AVAILABLE

TOPS: SCOUT  
Conglomerate 3461  
Mississippi 3470  
Total Depth 3473

RECEIVED  
STATE CORPORATION COMMISSION  
NOV 1 1971  
CONSERVATION DIVISION  
Wichita, Kansas