


STATE OF KANSAS
STATE CORPORATION COMMISSION

WELL PLUGGING RECORD

Give All Information Completely
Make Required Affidavit
Mail or Deliver Report to
Conservation Division
State Corporation Comm.
245 North Water
Wichita, KS 67202

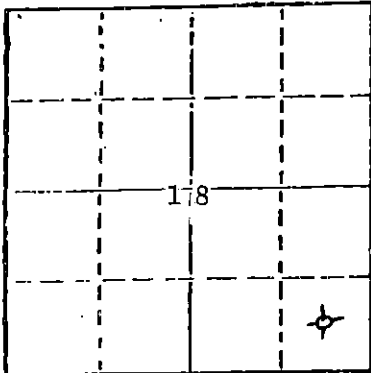

Locate well correctly on above
Section Plat

Kingman County, Sec. 18 Twp. 30S Rge. 10W E/W
Location as "NE/CNW $\frac{1}{4}$ SW $\frac{1}{4}$ " or footage from lines
C SE SE

Lease Owner Rupe Oil Co., Inc.
Lease Name L. W. Westerman Well No. 1
Office Address P. O. Box 2273, Wichita, KS 67201
Character of Well (Completed as Oil, Gas or Dry Hole)
dry hole

Date Well completed October 12 1978
Application for plugging filed October 12 1978
Application for plugging approved October 12 1978
Plugging commenced October 12 1978
Plugging completed October 12 1978
Reason for abandonment of well or producing formation
Dry hole

If a producing well is abandoned, date of last production
19

Was permission obtained from the Conservation Division or
its agents before plugging was commenced? yes,

Name of Conservation Agent who supervised plugging of this well Wm. T. Owen
Producing formation Depth to top Bottom Total Depth of Well 3681
Show depth and thickness of all water, oil and gas formations.

OIL, GAS OR WATER RECORDS

CASING RECORD

FORMATION	CONTENT	FROM	TO	SIZE	PUT IN	PULLED OUT

Describe in detail the manner in which the well was plugged, indicating where the mud fluid
was placed and the method or methods used in introducing it into the hold. If cement or other
plugs were used, state the character of same and depth placed, from feet to
feet for each plug set.

First plug set at 240' with 40 sacks

Second plug set at 40' with 12 sacks

Three sacks in rat hole

RECEIVED
STATE CORPORATION COMMISSION

OCT 26 1978

CONSERVATION DIVISION
Wichita, Kansas

10-26-1978

(If additional description is necessary, use BACK of this sheet)

Name of Plugging Contractor Union Drilling Co., Inc.

STATE OF KANSAS COUNTY OF SEDGWICK, ss.
R. D. Messinger (employee of owner) or (owner or operator)
of the above-described well, being first duly sworn on oath, says: That I have knowledge of
the facts, statements, and matters herein contained and the log of the above-described well
as filed and that the same are true and correct. So help me God.

(Signature)

505 Union Center, Wichita, Kansas

(Address)

October, 1978

SUBSCRIBED AND SWORN TO before me this 12th day of

My commission expires 6-2-82

Cynthia L. Romey

Notary Public.



CONTRACTOR'S WELL LOG

OPERATOR:	Rupe Oil Co., Inc.
CONTRACTOR:	Union Drilling Co., Inc.
WELL NAME:	L. W. Westerman #1
LOCATION:	C SE SE Section 18-30S-10W Kingman County, Kansas
COMMENCED:	October 2, 1978
COMPLETED:	October 12, 1978

0	249	Sand	Set 8 5/8" @ 243 w/ 180 sx.
249	879	Shale	
879	1424	Sand and shale	
1424	1737	Shale and lime	
1737	2077	Lime and shale	
2077	2260	Shale and lime	
2260	2424	Lime and shale	
2424	2584	Shale	
2584	2720	Lime and shale	
2720	2732	Shale and lime	
2732	2919	Lime and shale	
2919	2989	Shale	
2989	3090	Shale and lime	
3090	3401	Lime and shale	
3401	3451	Shale and lime	
3451	3625	Lime and shale	
3625	3675	Shale and lime	
3675	3681	Lime and shale	
	3681	T. D.	

RECEIVED
STATE CORPORATION COMMISSION
OCT 26 1978
CONSERVATION DIVISION
Wichita, Kansas

We certify that the above and foregoing is a true and correct copy of the log on the L. W. Westerman #1, C SE SE Section 18-30S-10W, Kingman County, Kansas.


UNION DRILLING CO., INC.

R. D. Messenger
R. D. Messenger

STATE OF KANSAS)
COUNTY OF SEDGWICK) SS

Subscribed and sworn ot before me, a Notary Public, in and for aforesaid County and State as of this 23rd day of October, 1978.

My appointment expires:

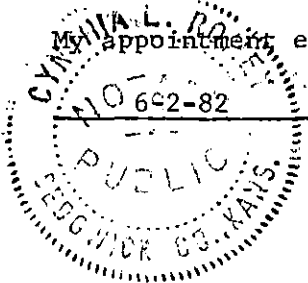

Cynthia L. Romey
Cynthia L. Romey, Notary Public