

STATE OF KANSAS
STATE CORPORATION COMMISSION


Form CP-4

Give All Information Completely
Make Required Affidavit
Mail or Deliver Report to:
Conservation Division
State Corporation Commission
212 No. Market
Wichita, Kansas

WELL PLUGGING RECORD

KINGMAN County, Sec. 31 Twp. 30s Rge. 9 (##) (W)
NE NE SE

NORTH

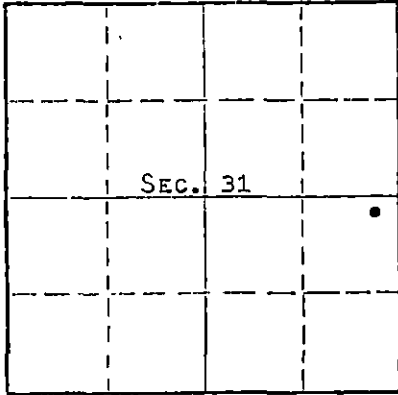

Locate well correctly on above
Section Plat

Location as "NE/CNW/SW" or footage from lines
Lease Owner PETROLEUM, INC.
Lease Name COX Well No. C-1
Office Address R.R.#2, GREAT BEND, KANSAS
Character of Well (completed as Oil, Gas or Dry Hole) GAS WELL
Date well completed JAN. 12, 19 57
Application for plugging filed JULY 19, 19 68
Application for plugging approved JULY 22, 19 68
Plugging commenced JULY 22, 19 68
Plugging completed JULY 24, 19 68
Reason for abandonment of well or producing formation DEPLETION OF PRODUCING ZONE

If a producing well is abandoned, date of last production APRIL 27, 19 68
Was permission obtained from the Conservation Division or its agents before plugging was commenced? YES

Name of Conservation Agent who supervised plugging of this well R. J. WARREN
Producing formation MISSISSIPPI Depth to top 4355 Bottom 4495 Total Depth of Well 4495' Feet
Show depth and thickness of all water, oil and gas formations.

OIL, GAS OR WATER RECORDS

CASING RECORD

FORMATION	CONTENT	FROM	TO	SIZE	PUT IN	PULLED OUT
MISSISSIPPI	SLIGHT AMOUNT OF GAS & WATER	4358	4368	8-5/8"	220	NONE
				5 1/2"	4492	3842'

Describe in detail the manner in which the well was plugged, indicating where the mud fluid was placed and the method or methods used in introducing it into the hole. If cement or other plugs were used, state the character of same and depth placed, from _____ feet to _____ feet for each plug set.

PLUGGED BACK 4454' TO 4300', MIXED AND DUMPED 5 SACKS CEMENT FROM 4300' TO 4260'. HEAVY MUD TO 220'. SET 10' ROCK BRIDGE FROM 220' TO 210'. MIXED AND DUMPED 25 SACKS CEMENT FROM 210' TO 135', HEAVY MUD FROM 135' TO 40'. SET 10' ROCK BRIDGE FROM 40' TO 30'. MIXED AND DUMPED 10 SACKS CEMENT FROM 30' TO BASE OF WELL CELLAR.

RECEIVED
STATE CORPORATION COMMISSION
AUG 5 1968
CONSERVATION DIVISION
Wichita, Kansas

(If additional description is necessary, use BACK of this sheet)
Name of Plugging Contractor RUSS CASING PULLING INC.
Address BOX 1082, GREAT BEND, KANSAS 67530

STATE OF KANSAS, COUNTY OF BARTON, ss.
MONTE CHADD (employee of owner) or (owner) of the above-described well, being first duly sworn on oath, says: That I have knowledge of the facts, statements, and matters herein contained and the log of the above-described well as filed and that the same are true and correct. So help me God. MONTE CHADD, DIST. PROD. SUPT.

(Signature) *Monte Chadd*
ROUTE 2, GREAT BEND, KANSAS
(Address)

SUBSCRIBED AND SWORN TO before me this 2 day of AUGUST, 19 68

My commission expires MAY 28, 1969 *Richard H. Dumbler* Notary Public.

WELL LOG

15. 095. 00654. 00. 00

COMPANY PETROLEUM, INCORPORATED

SEC. 31 T. 30S R. 9W

FARM COX 'C' NO. 1


LOC. NE, NE, SE

TOTAL DEPTH 4495'

COUNTY Kingman Co., Kansas

COMM. December 15, 1956 COMP. January 4, 1957

CONTRACTOR GARVEY DRILLING COMPANY

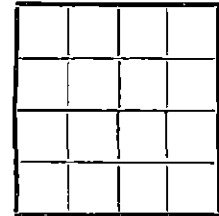

CASING 8 5/8" @ 220' W/150 sax.
5 1/2" @ 4492' W/100 sax.

ELEVATION 1663' DF

PRODUCTION Mississippian

FIGURES INDICATE BOTTOM OF FORMATIONS

33	Clay & sand
70	Sand
220	Shale
485	Red bed
830	Red bed & shale
1340	Shale & shells
1465	Shale
1480	Anhydrite
1640	Shale & lime
1828	Lime
1950	Lime & shale
1965	Sand
2030	Lime
3162	Lime & shale
3246	Lime
3343	Lime & shale
3572	Lime
3615	Sand & shale
3695	Lime & shale
4352	Lime
4355	Lime & shale
4380	Cherty lime
4405	Chert
4446	Cherty lime
4452	Mississippi lime
4495	Lime & chert.
4495	T. D.

RECEIVED
STATE CORPORATION COMMISSION
AUG 5 1968
CONSERVATION DIVISION
Wichita, Kansas

State of KANSAS }
County of BARTON } ss:

I, Verne A. Morris of Garvey Drilling Co.

upon oath state that the above and foregoing is a true and correct copy of the log of the #1 Cox 'C' well

Verne A. Morris

Subscribed and sworn to before me this 19th day of January 19 57

My Commission Expires: July 11, 1960

Jed J. Brown
NOTARY PUBLIC