


STATE OF KANSAS  
STATE CORPORATION COMMISSION

WELL PLUGGING RECORD

Give All Information Completely  
Make Required Affidavit  
Mail or Deliver Report to:  
Conservation Division  
State Corporation Commission  
212 No. Market  
Wichita, Kansas

Kingman County. Sec. 16 Twp. 30S Rge. (E) 9 (W)  
Location as "NE/CNW/SE/SW" or footage from lines. SE NE SW  
Lease Owner Tilco, et al  
Lease Name Harris Well No. 1  
Office Address 815 Wichita Plaza, Wichita, Kansas  
Character of Well (completed as Oil, Gas or Dry Hole) Dry Hole  
Date well completed 3-12 1969  
Application for plugging filed 3-12 1969  
Application for plugging approved 3-12 1969  
Plugging commenced 3-12 1969  
Plugging completed 3-12 1969  
Reason for abandonment of well or producing formation Dry Hole

NORTH

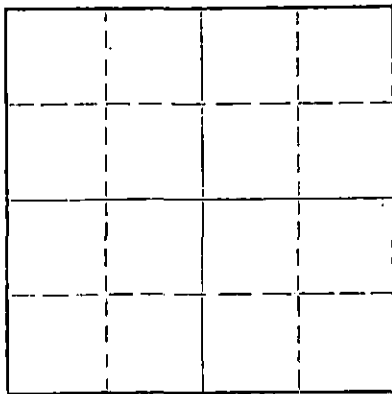

Locate well correctly on above Section Plat

If a producing well is abandoned, date of last production. 19  
Was permission obtained from the Conservation Division or its agents before plugging was commenced? Yes

Name of Conservation Agent who supervised plugging of this well Ralph Warren  
Producing formation \_\_\_\_\_ Depth to top \_\_\_\_\_ Bottom \_\_\_\_\_ Total Depth of Well 4400 Feet  
Show depth and thickness of all water, oil and gas formations.

OIL, GAS OR WATER RECORDS

CASING RECORD

FORMATION	CONTENT	FROM	TO	SIZE	PUT IN	PULLED OUT
				8 5/8"	258'	none

Describe in detail the manner in which the well was plugged, indicating where the mud fluid was placed and the method or methods used in introducing it into the hole. If cement or other plugs were used, state the character of same and depth placed, from \_\_\_\_\_ feet to \_\_\_\_\_ feet for each plug set.

Plugged with 1/2 sx hulls @ 240' 1/2 sack hulls cement  
Filled hole to 40' with mud 1/2 sack hulls Plug & 1/2 sx hulls 10 cement.

RECEIVED  
STATE CORPORATION COMMISSION  
MAR 18 1969  
CONSERVATION DIVISION  
Wichita, Kansas

(If additional description is necessary, use BACK of this sheet)

Name of Plugging Contractor Leben Drilling, Inc.  
Address Box 486, Great Bend, Kansas 67530

STATE OF KANSAS, COUNTY OF BARTON, ss.  
Leslie Kite (employee of owner) or (owner or operator) of the above-described well, being first duly sworn on oath, says: That I have knowledge of the facts, statements, and matters herein contained and the log of the above-described well as filed and that the same are true and correct. So help me God.

(Signature) Leslie Kite  
(Address) \_\_\_\_\_

SUBSCRIBED AND SWORN to before me this 15th day of March, 1969

My commission expires April 1, 1971

Ulanda Nichols  
Notary Public.

DRILLER'S LOG

COMPANY	Tilco, et al
CONTRACTOR	LEBEN DRILLING, INC.
FARM	HARRIS #1
LOCATION	SE NE SW SECTION 16-30S-9W KINGMAN COUNTY, KANSAS
COMMENCED	3-3-69
COMPLETED	3-12-69

0	100	Sand
100	600	Red Bed
600	1171	Shale
1171	1177	Anhydrite
1177	1500	Shale, Shells
1500	2046	Lime, Shale
2046	2670	Shale, Lime
2670	2920	Shale, Shells
2920	3172	Shale, Lime
3172	3440	Lime
3440	3708	Shale, Sand, Lime
3708	4400	Lime
	<u>4400</u>	<u>RTD - D. &amp; A.</u>

RECEIVED  
STATE CORPORATION COMMISSION  
MAR 18 1969  
CONSERVATION DIVISION  
Wichita, Kansas

8 5/8" 20# new surface casing set @ 258' cemented with 185 sacks Common cement, 2% cc

I, Leslie Kite, do hereby certify that the above and foregoing is a true and correct copy of the log of the Harris #1 Well, located SE NE SW of Section 16, Township 30 South, Range 9 West, Kingman County, Kansas, as reflected by the records of Leben Drilling, Inc.

Leslie Kite  
Leslie Kite

STATE OF KANSAS )  
                          ) SS  
COUNTY OF BARTON )

Subscribed and sworn to and before me, a Notary Public, in and for Barton County, Kansas, this 15th day of March, 1969.

Ulanda Nichols  
Ulanda Nichols

My Commission Expires:  
April 1, 1971