


STATE OF KANSAS
STATE CORPORATION COMMISSION

WELL PLUGGING RECORD

Give All Information Completely
Make Required Affidavit
Mail or Deliver Report to
Conservation Division
State Corporation Comm.
245 North Water
Wichita, KS 67202

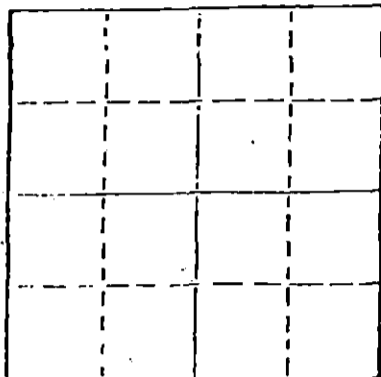

Locate well correctly on above
Section Plot

Kingman County, Sec. 13 Twp. 30 Rge. 9 NE/W
Location as "NE/CNW $\frac{1}{4}$ SW $\frac{1}{4}$ " or footage from lines
NE/NE/NE
Lease Owner Petroleum, Inc.
Lease Name Graber Well No. "B" 1
Office Address Box 1447 - Great Bend, Ks. 67530
Character of Well (Completed as Oil, Gas or Dry Hole)
Oil
Date Well completed 19
Application for plugging filed 19
Application for plugging approved 19
Plugging commenced July 21, 1981 19
Plugging completed July 28, 1981 19
Reason for abandonment of well or producing formation
Depletion
If a producing well is abandoned, date of last production
19

Was permission obtained from the Conservation Division or
its agents before plugging was commenced? Yes

Name of Conservation Agent who supervised plugging of this well Maurice Leslie
Producing formation _____ Depth to top _____ Bottom _____ Total Depth of Well
Show depth and thickness of all water, oil and gas formations. 4281'

OIL, GAS OR WATER RECORDS

CASING RECORD

FORMATION	CONTENT	FROM	TO	SIZE	PUT IN	PULLED OUT
				8 5/8"	266'	NONE
				4 1/2"	4279'	3093.78'

Describe in detail the manner in which the well was plugged, indicating where the mud fluid
was placed and the method or methods used in introducing it into the hold. If cement or other
plugs were used, state the character of same and depth placed, from _____ feet to
_____ feet for each plug set.

Dump sand to 4200' and four (4) sacks cement.

Shot pipe @ 3200', and 3130'.

~~Pulled fifty-one (51) joints of pipe.~~

Pulled ninety-three (93) joints of 4 1/2" casing.

Squeezed well with four (4) sacks hulls, fifteen (15) sacks gel,
seventy (70) sacks 60/40 pozmix cement, one (1) sack hulls, fifteen (15)
sacks gel and seventy (70) sacks 60/40 pozmix cement.

RECEIVED
STATE CORPORATION COMMISSION

AUG 10 1981

(If additional description is necessary, use BACK of this sheet)

Name of Plugging Contractor Rockhold Engineering, Inc.

CONSERVATION DIVISION
Wichita Kansas

STATE OF KANSAS COUNTY OF BARTON 8-10-1981
James W. Rockhold (employee of owner) or (owner or operator)
of the above-described well, being first duly sworn on oath, says: That I have knowledge of
the facts, statements, and matters herein contained and the log of the above-described well
as filed and that the same are true and correct. So help me God.

(Signature) James W. Rockhold
James W. Rockhold - Box 698 - Great Bend, Ks. 67530
(Address)

SUBSCRIBED AND SWORN TO before me this 7th day of August, 1981

Luck Brant

Notary Public.

My commission expires _____



WELL LOG

15.095.10038.00.00

COMPANY **PETROLEUM, INCORPORATED**

SEC. 13 T. 30S. 9W

FARM **GRABER "B" NO. 1**

LOC. NE, NE, NE


TOTAL DEPTH **4281'**

COUNTY **KINGMAN CO., KANSAS**

COMM. **May 8, 1959**

COMP. **May 19, 1959**

CONTRACTOR **GARVEY DRILLING COMPANY**

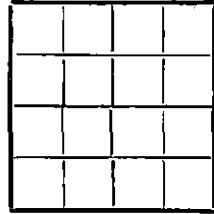

CASING **8 5/8" @ 266' W/225 sax.
4 1/2" @ 4279' W/250 sax.**

ELEVATION **1591' DF**

PRODUCTION **MISSISSIPPIAN**

FIGURES INDICATE BOTTOM OF FORMATIONS

40.	Surface clay & sand
80	Sand & gravel
266	Red bed
876	Shale & shells
1430	Shale, shells & lime
1605	Shale & lime
1935	Lime
2085	Lime & shale
2490	Shale
3330	Shale & lime
3515	Lime & shale
3975	Lime
4256	Lime & shale
4281	Chert
4281	T. D.

State of KANSAS }
County of BARTON } ss:

I, VERNE A. MORRIS of GARVEY DRILLING COMPANY

upon oath state that the above and foregoing is a true and correct copy of the log of the #1 GRABER "B" well

Verne A. Morris

Subscribed and sworn to before me this 8th day of July 19 59

My Commission Expires: April 14, 1963

Arthur J. Wiles
NOTARY PUBLIC