

STATE OF KANSAS
STATE CORPORATION COMMISSION

Form CP-4

WELL PLUGGING RECORD

Give All Information Completely
Make Required Affidavit
Mail or Deliver Report to:
Conservation Division
State Corporation Commission
211 No. Broadway
Wichita, Kansas

KINGMAN County, Sec. 13 Twp. 30s Rge. 9 (R) (W)

Location as "NE/CNW/SW" or footage from lines SW NW SW

Lease Owner PETROLEUM, INC.

Lease Name HUNTER "E" Well No. 1

Office Address ROUTE #2, GREAT BEND, KANSAS

Character of Well (completed as Oil, Gas or Dry Hole) DRY HOLE

Date well completed JULY 19 19 65

Application for plugging filed JULY 19 19 65

Application for plugging approved JULY 19 19 65


Plugging commenced JULY 19 19 65

Plugging completed JULY 19 19 65

Reason for abandonment of well or producing formation NO PRODUCIBLE ZONES

If a producing well is abandoned, date of last production NONE 19

Was permission obtained from the Conservation Division or its agents before plugging was commenced? YES

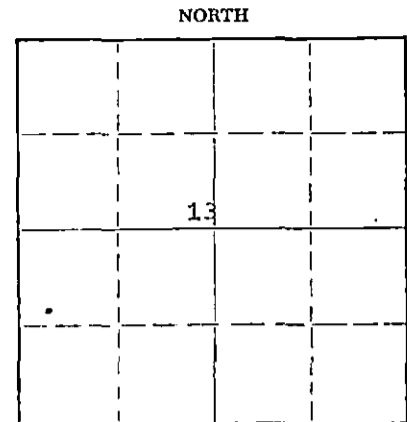

Locate well correctly on above Section Plat

Name of Conservation Agent who supervised plugging of this well ARCHIE ELYING

Producing formation - Depth to top - Bottom - Total Depth of Well 4298 Feet

Show depth and thickness of all water, oil and gas formations.

OIL, GAS OR WATER RECORDS

CASING RECORD

FORMATION	CONTENT	FROM	TO	SIZE	PUT IN	PULLED OUT
				8-5/8"	214'	NONE

Describe in detail the manner in which the well was plugged, indicating where the mud fluid was placed and the method or methods used in introducing it into the hole. If cement or other plugs were used, state the character of same and depth placed, from feet to feet for each plug set.

MUDDED UP WITH HEAVY MUD TO 200', FOLLOWED BY WOODEN PLUG. PLACED 25 SACKS CEMENT THRU DRILL PIPE TOP OF PLUG. MUDDED UP WITH HEAVY MUD TO 40' FOLLOWED BY WOODEN PLUG. PLACED 1/2 SACK HULLS, 10 SACKS CEMENT TO BASE OF WELL CELLAR.

RECEIVED
STATE CORPORATION COMMISSION

JUL 26 1965

CONSERVATION DIVISION
Wichita, Kansas

7-26-1965

(If additional description is necessary, use BACK of this sheet)

Name of Plugging Contractor GARVEY DRILLING CO.

Address ROUTE #2, GREAT BEND, KANSAS

STATE OF KANSAS, COUNTY OF BARTON, ss. MONTE CHADD (employee of owner) or (owner/lessee/operator) of the above-described well, being first duly sworn on oath, says: That I have knowledge of the facts, statements, and matters herein contained and the log of the above-described well as filed and that the same are true and correct. So help me God. MONTE CHADD, DIST. PROD. SUPT.

(Signature) *Monte Chadd*

R.R. #2, GREAT BEND, KANSAS (Address)

SUBSCRIBED AND SWORN TO before me this 20 day of JULY, 19 65

My commission expires May 28, 1969

Richard H. Dunder
Notary Public.

COMPANY Petroleum, Inc.

SEC. 13 T. 30S R. 9W

FARM Hunter

NO. E-1

LOC. SW NW SW


TOTAL DEPTH 4298'

COUNTY Kingman

COMM. 7-9-65

COMP. 7-19-65

CONTRACTOR Garvey Drilling Company

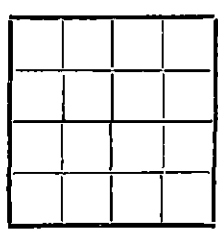

CASING 8 5/8" @ 214' w/221 sx

ELEVATION 1612' DF

PRODUCTION D & A

FIGURES INDICATE BOTTOM OF FORMATIONS

- 40' Clay and Sand
- 320' Red Bed and Shale
- 760' Shale
- 1275' Shale and Shells
- 1360' Shale with Lime Streaks
- 1640' Shale and Lime
- 1850' Lime and Shale
- 1964' Lime with Shale
- 2195' Shale
- 2375' Lime and Shale
- 2625' Lime with Shale
- 3045' Shale and Lime
- 3220' Lime with Shale
- 3545' Lime and Shale
- 4029' Lime
- 4073' Lime and Shale
- 4115' Lime
- 4200' Lime and Shale
- 4263' Shale and Lime
- 4293' Lime with Shale
- 4298' Lime
- 4298' RTD

RECEIVED
 STATE CORPORATION COMMISSION
 JUL 26 1965
 CONSERVATION DIVISION
 Wichita, Kansas

State of Kansas }
 County of Barton } 85

I, Sam N. Stephens of Garvey Drilling Company

upon oath state the above and foregoing is a true and correct copy of the log of the Hunter E-1 well.

Sam N. Stephens

Subscribed and sworn to before me this 23rd day of July 19 65

My Commission Expires: May 28, 1969

Richard H. Dumber
 NOTARY PUBLIC