


WELL PLUGGING RECORD

Give All Information Completely
Make Required Affidavit
Mail or Deliver Report to:
Conservation Division
State Corporation Commission
212 North Market, Insurance Bldg.
Wichita, Kansas

NORTH

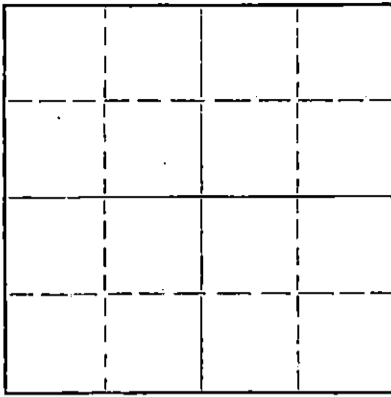

Locate well correctly on above
Section Plat

Kingman County. Sec. 13 Twp. 30 Rge. 9 (E) W. (W)
Location as "NE/CNW/SW" or footage from lines 330' N. & 480' E. of S/4 Cor.
Lease Owner Cities Service Petroleum Company, et al.
Lease Name Nicholas Well No. 1
Office Address Box 308, Great Bend, Kansas
Character of Well (completed as Oil, Gas or Dry Hole) Dry Hole
Date well completed February 20 19 62
Application for plugging filed February 20 19 62
Application for plugging approved February 20 19 62
Plugging commenced February 20 19 62
Plugging completed February 21 19 62
Reason for abandonment of well or producing formation Dry Hole

If a producing well is abandoned, date of last production - 19 -
Was permission obtained from the Conservation Division or its agents before plugging was commenced? Yes

Name of Conservation Agent who supervised plugging of this well Fred W. Hampel
Producing formation - Depth to top - Bottom - Total Depth of Well 4295 Feet
Show depth and thickness of all water, oil and gas formations.

OIL, GAS OR WATER RECORDS

CASING RECORD

FORMATION	CONTENT	FROM	TO	SIZE	PUT IN	PULLED OUT
				8-5/8"	408'	None

Describe in detail the manner in which the well was plugged, indicating where the mud fluid was placed and the method or methods used in introducing it into the hole. If cement or other plugs were used, state the character of same and depth placed, from _____ feet to _____ feet for each plug set.

4295-300', heavy mud.
300-240', wood plug, hulls and 20 sacks cement.
240- 35', mud.
35- 0', wood plug, hulls and 10 sacks cement to base of cellar.

RECEIVED
STATE CORPORATION COMMISSION

MAR 2 1962

CONSERVATION DIVISION
Wichita, Kansas

3-2-1962

(If additional description is necessary, use BACK of this sheet)

Name of Plugging Contractor Garvey Drilling Company
Address Route 2, Great Bend, Kansas

STATE OF Kansas, COUNTY OF Barton, ss.
John D. Forsyth (employee of owner) or (owner or contractor) of the above-described well, being first duly sworn on oath, says: That I have knowledge of the facts, statements, and matters herein contained and the log of the above-described well as filed and that the same are true and correct. So help me God.

(Signature) John D. Forsyth
Box 308, Great Bend, Kansas
(Address)

SUBSCRIBED AND SWORN TO before me this 26th day of February, 19 62

W.D. Smith
Notary Public.

My commission expires March 12, 1963.

WELL RECORD

WILDCAT.....

DISCOVERY.....

POOL.....

Cities Service Petroleum Co.
 COMPANY and Petroleum, Inc. WELL # 1 FARM Nicholas

LOCATION 330' North and 480' East of S/4 Corner
Section 13, Township 30, Range 9 West.

ELEV. 1582 D.F. CO. Kingman STATE Kansas

IP. Dry hole. P. and A. February 21, 1962.

PERFS.....

FRAC..... ACID None

T.D. 4295' PBTD..... GRAV/GOR.....

DRLG. COMM. February 8, 1962 COMP. February 20, 1962 CONTRACTOR Garvey Drlg. Co.

CASING RECORD:

8-5/8" at 408' with 275 sacks cement.

FORMATION RECORD:

clay, sand and red bed	0-45
red bed and shale	385
shale and shells	410
red bed and shale	630
shale and shells	1112
lime	1137
shale and shells	1285
lime and shale	1390
shale and lime	1490
lime and shale	1598
lime	1925
shale and lime streaks	2095
lime and shale	2295
shale and lime	2690
lime and shale	3140
lime broken	3240
lime and shale	3435
lime	4115
lime and shale	4205
lime and chert	4235
chert	4250
lime	4295 T.D.

Slope Tests (Sure Shot):

250'	- 1°
385'	- 1/4°
900'	- 1/4°
1400'	- 3/4°
1900'	- 3/4°
2400'	- 1/2°
2900'	- 1-1/4°
3400'	- 1°
3850'	- 3/4°

RECEIVED
 COMMISSION
 MAR 3 1962
 CONSERVATION DIVISION
 Wichita, Kansas