


STATE OF KANSAS
STATE CORPORATION COMMISSION

Form CP-4

Give All Information Completely.
Make Required Affidavit
Mail or Deliver Report to:
Conservation Division
State Corporation Commission
212 No. Market
Wichita, Kansas

WELL PLUGGING RECORD

Kingman County, Sec. 4 Twp. 30 Rge. 9 (E) (W)x
Location as "NE/CNW/SW" or footage from lines C NE NE
Lease Owner Imperial Oil Co.
Lease Name Morisse Well No. #1
Office Address Box 736, Great Bend, Kansas
Character of Well (completed as Oil, Gas or Dry Hole)
Date well completed 19
Application for plugging filed 19
Application for plugging approved 19
Plugging commenced 6-8-70 19
Plugging completed 6-10-70 19
Reason for abandonment of well or producing formation

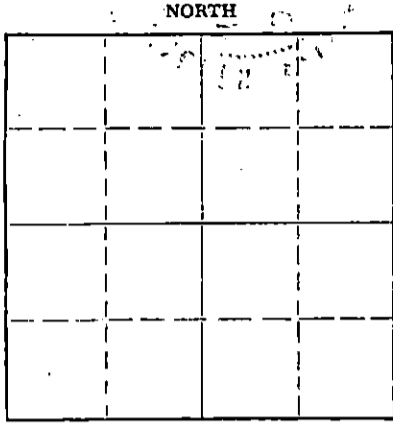

Locate well correctly on above Section Plat

If a producing well is abandoned, date of last production 19
Was permission obtained from the Conservation Division or its agents before plugging was commenced?

Name of Conservation Agent who supervised plugging of this well G. R. Biberstein
Producing formation Depth to top Bottom Total Depth of Well 4235' Feet
Show depth and thickness of all water, oil and gas formations.

OIL, GAS OR WATER RECORDS

CASING RECORD

FORMATION	CONTENT	FROM	TO	SIZE	PUT IN	PULLED OUT
				4 1/2"	4221'	3510.92'
				8 5/8"	289'	

Describe in detail the manner in which the well was plugged, indicating where the mud fluid was placed and the method or methods used in introducing it into the hole. If cement or other plugs were used, state the character of same and depth placed, from feet to feet for each plug set.

Made bottom hole plug back with sand to 4200'. Mixed and ran 3 sacks cement thru dump bailer.
Mudded hole to 275' - set 10' rock bridge. Mixed and ran 25 sacks cement thru dump bailer. Mudded hole to 50', set 10' rock bridge. Mixed and dumped 10 sacks cement to base of cellar.

RECEIVED
STATE CORPORATION COMMISSION
JUN 15 1970
CONSERVATION DIVISION
Wichita, Kansas

(If additional description is necessary, use BACK of this sheet)

Name of Plugging Contractor Southwest Casing Pulling Co.
Address Box 364, Great Bend, Kansas

STATE OF Kansas, COUNTY OF Barton, ss.
Southwest Casing Pulling Co. (employee of owner) or (owner or operator) of the above-described well, being first duly sworn to oath, says: That I have knowledge of the facts, statements, and matters herein contained and the log of the above-described well as filed and that the same are true and correct. So help me God.

(Signature) W. C. Spencer Sec.
Box 364, Great Bend, Kansas
(Address)

Subscribed and sworn to before me this 11 day of June, 19 70

My commission expires October 1972
Notary Public
SIDNEY D. MILLER
NOTARY PUBLIC
BARTON COUNTY, KANSAS

Sidney D. Miller
Notary Public.