

JUL 24 1979

15.095.20856.00.00


FORM CP-4

STATE OF KANSAS
STATE CORPORATION COMMISSION

WELL PLUGGING RECORD

Give All Information Completely
Make Required Affidavit
Mail or Deliver Report to
Conservation Division
State Corporation Comm.
245 North Water
Wichita, KS 67202

Kingman County, Sec. 2 Twp. 30S Rge. 9W /#/#
Location as "NE/CNW $\frac{1}{4}$ SW $\frac{1}{4}$ " or footage from lines
660' E & 500' N of SW Corner of NW/4
Lease Owner Gear Petroleum Company
Lease Name Whitmer Well No. 1
Office Address 300 Sutton Place, Wichita, Kansas 67202
Character of Well (Completed as Oil, Gas or Dry Hole) D & A
Date Well completed July 17, 1979
Application for plugging filed July 17, 1979
Application for plugging approved July 17, 1979
Plugging commenced July 18, 1979
Plugging completed July 18, 1979
Reason for abandonment of well or producing formation D & A

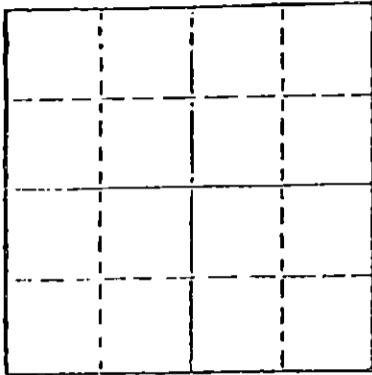

Locate well correctly on above
Section Plat

If a producing well is abandoned, date of last production 19
Was permission obtained from the Conservation Division or
its agents before plugging was commenced? Yes

Name of Conservation Agent who supervised plugging of this well Wm. T. Owen
Producing formation _____ Depth to top _____ Bottom _____ Total Depth of Well 4,240'
Show depth and thickness of all water, oil and gas formations.

OIL, GAS OR WATER RECORDS

CASING RECORD

FORMATION	CONTENT	FROM	TO	SIZE	PUT IN	PULLED OUT
				8 5/8"	218.66'	-0-

Describe in detail the manner in which the well was plugged, indicating where the mud fluid was placed and the method or methods used in introducing it into the hold. If cement or other plugs were used, state the character of same and depth placed, from _____ feet to _____ feet for each plug set.

Plug @ 210' w/40 sx cement
Plug @ 40' w/12 sx cement
3 sx cement in rathole

RECEIVED
STATE CORPORATION COMMISSION
JUL 25 1979
CONSERVATION DIVISION
Wichita, Kansas

(If additional description is necessary, use BACK of this sheet)

Name of Plugging Contractor Red Tiger Drilling Company
1720 KSB&T Building, Wichita, Kansas 67202

STATE OF Kansas COUNTY OF Sedgwick, ss. contractor
Gloria Fawcett (employee of ~~xxxxxx~~)


of the above-described well, being first duly sworn on oath, says: That I have knowledge of the facts, statements, and matters herein contained and the log of the above-described well as filed and that the same are true and correct. So help me God.

(Signature) Gloria Fawcett
1720 KSB&T Building, Wichita, Kansas 67202
(Address)

SUBSCRIBED AND SWORN TO before me this 23rd day of July, 1979.

Joyce A. Hagermann
Notary Public.

My commission expires _____

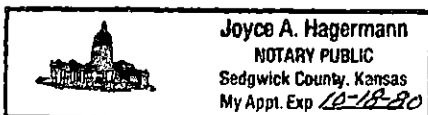

JUL 24 1979

15.095.20856.00.00

DRILLERS LOG


No. 1 Whitmer

CASING RECORD:	COMPANY:	Gear Petroleum Company	DESCRIPTION:
8 5/8" @ 226' w/200 sx cement	CONTRACTOR:	Red Tiger Drilling Company	660' E & 500' N of SW Corner of NW/4 Sec. 2-T30S-R9W Kingman County, Kansas
	COMMENCED:	July 10, 1979	
	COMPLETED:	July 18, 1979	
TOTAL DEPTH: 4,240'			ELEVATION: 1,611' KB


<u>FORMATION</u>	<u>FROM</u>	<u>TO</u>	<u>REMARKS</u>
Shale	0	228	
Red Bed, Clay & Shale	228	1028	
Shale	1028	1618	
Lime & Shale	1618	4240	
RTD		4240	

I certify that this is a true and correct copy of the above log to the best of my knowledge.

RED TIGER DRILLING COMPANY

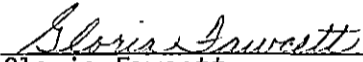
 Gloria Fawcett

Subscribed and sworn to before me this 23rd day of July, 1979.

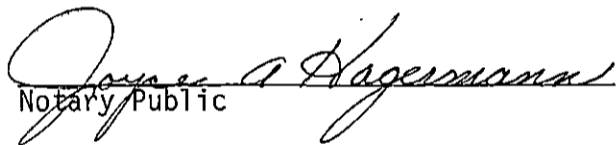
 Notary Public

