


STATE OF KANSAS  
STATE CORPORATION COMMISSION

WELL PLUGGING RECORD

Give All Information Completely  
Make Required Affidavit  
Mail or Deliver Report to:  
Conservation Division  
State Corporation Commission  
800 Banking Building  
Wichita, Kansas

NORTH

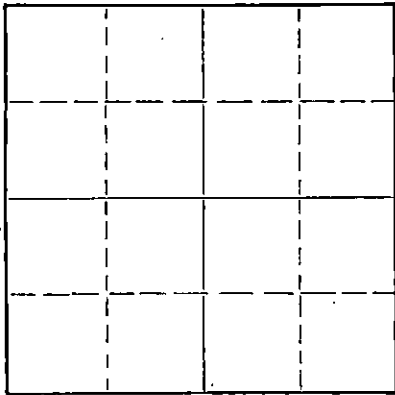

Locate well correctly on above  
Section Plat

Kingman County. Sec. 2 Twp. 30 Rge. (E) 9 (W)  
Location as "NE/CNW/SW" or footage from lines SW NE NW  
Lease Owner Rupp-Ferguson Oil Co.  
Lease Name Whitmer Well No. 1  
Office Address 523 Petroleum Bldg., Wichita, Kansas  
Character of Well (completed as Oil, Gas or Dry Hole) Dry Hole  
Date well completed 10-9-55 19  
Application for plugging filed 10-9-55 19  
Application for plugging approved 10-9-55 19  
Plugging commenced 10-9-55 19  
Plugging completed 10-9-55 19  
Reason for abandonment of well or producing formation

If a producing well is abandoned, date of last production 19  
Was permission obtained from the Conservation Division or its agents before plugging was commenced? Yes

Name of Conservation Agent who supervised plugging of this well M. A. Rives  
Producing formation Depth to top Bottom Total Depth of Well 4195 Feet  
Show depth and thickness of all water, oil and gas formations.

OIL, GAS OR WATER RECORDS

CASING RECORD

FORMATION	CONTENT	FROM	TO	SIZE	PUT IN	PULLED OUT
				8 5/8	220'	0

Describe in detail the manner in which the well was plugged, indicating where the mud fluid was placed and the method or methods used in introducing it into the hole. If cement or other plugs were used, state the character of same and depth placed, from feet to feet for each plug set.

Filled hole with mud to 210' - 1/3 sack hulls and plug to 210'. Cemented thru 7 joints drill pipe w/20 sack cement. Filled hole with mud to 35', 1/3 sack hulls and plug to 35'. Cemented to base of cellar w/10 sacks.

(If additional description is necessary, use BACK of this sheet)

Name of Plugging Contractor Rupp-Ferguson Oil Co.  
Address 523 Petroleum Bldg., Wichita, Kansas

STATE OF Kansas, COUNTY OF Sedgwick, ss.  
Kenneth Rupp (employer of owner) or (owner or operator) of the above-described well, being first duly sworn on oath, says: That I have knowledge of the facts, statements, and matters herein contained and the log of the above-described well as filed and that the same are true and correct. So help me God.

(Signature) Kenneth Rupp  
523 Petroleum Bldg., Wichita, Kansas  
(Address)

SUBSCRIBED AND SWORN TO before me this 14th day of October, 1955

Helen Horine  
Notary Public.

My commission expires June 4, 1959.

PLUGGING  
SEC 2 T 30 R 9 W  
BOOK PAGE 7 LINE 14

RECEIVED  
OCT 15 1955  
10/15/55  
CONSERVATION DIVISION  
Wichita, Kansas

## CONTRACTOR'S WELL LOG

Rupp-Ferguson No. 1 Whitmer  
SW NE NW, Sec. 2-30-9W, Kingman County, Kansas

Contractor: Rupp-Ferguson Oil Co.

Elev. 1570 KB  
D & A

Commenced: 9-27-55

Completed: 10-9-55

Ran 220' of 8 5/8" surface casing, cemented with 225 sacks

Figures Indicate Bottom of Formation

70. ss sand & blue shale  
220 red bed  
1015 red bed & shale  
1285 salt  
1595 lime & shale streaks  
2410 lime & shale  
2620 shale & shells  
2975 lime & shale  
3050 lime  
3290 lime & shale  
3401 sandy lime & shale  
3558 lime & shale  
3942 lime  
4185 shale & lime  
4195 Miss. T.D.

STATE OF KANSAS )  
                          ) SS:  
COUNTY OF SEDGWICK)


I, Kenneth Rupp, Partner in Rupp-Ferguson Oil Co., do hereby certify that the above and foregoing is a true and correct copy of the log of the No. 1 Whitmer well.

*Kenneth Rupp*  
Kenneth Rupp

Subscribed and sworn to before me this 14th day of October, 1955.

*Helen Horine*  
Notary Public

My Commission Expires June 4, 1959.

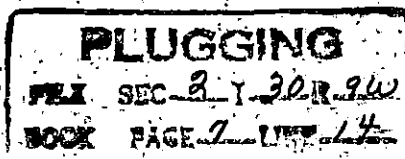

**RECEIVED**  
STATE CORPORATION COMMISSION  
OCT 15 1955  
CONSERVATION DIVISION  
Wichita, Kansas