


WELL PLUGGING RECORD

Give All Information Completely
Make Required Affidavit
Mail or Deliver Report to:
Conservation Division
State Corporation Commission
212 North Market, Insurance Bldg.
Wichita, Kansas

Kingman County, Sec. 2 Twp. 30 Rge. (E) 9 (W)

NORTH

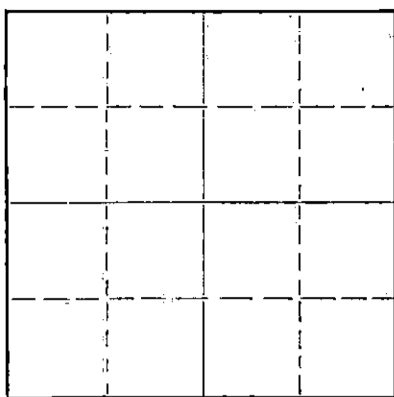

Locate well correctly on above
Section Plat

Location as "NE/CNW&SW&SE" or footage from lines C NE SW SE
Lease Owner Rupp-Ferguson Oil Co.
Lease Name Swingle Well No. 1
Office Address 522 Union Center, Wichita, Kansas
Character of Well (completed as Oil, Gas or Dry Hole) _____
Date well completed 12/15/58 19____
Application for plugging filed 2/23/61 19____
Application for plugging approved 2/28/61 19____
Plugging commenced 3/12/61 19____
Plugging completed 3/14/61 19____
Reason for abandonment of well or producing formation Depletion

If a producing well is abandoned, date of last production _____ 19____
Was permission obtained from the Conservation Division or its agents before plugging was commenced? Yes

Name of Conservation Agent who supervised plugging of this well Fred Hampel
Producing formation _____ Depth to top _____ Bottom _____ Total Depth of Well 4290 Feet
Show depth and thickness of all water, oil and gas formations.

OIL, GAS OR WATER RECORDS

CASING RECORD

FORMATION	CONTENT	FROM	TO	SIZE	PUT IN	PULLED OUT
				8 5/8"	253'	0
				5 1/2"	4290'	3443.97

Describe in detail the manner in which the well was plugged, indicating where the mud fluid was placed and the method or methods used in introducing it into the hole. If cement or other plugs were used, state the character of same and depth placed, from _____ feet to _____ feet for each plug set.

Shot casing at 3427'. Pumped 20 sacks jell and 20 sacks weight mud. Pulled 105 jts. Pumped 25 sacks cement. Plug to 245'. Filled with mud to 40' capped with 10 sacks cement to base of cellar.

STATE CORPORATION COMMISSION
APR 11 1961

CONSERVATION DIVISION
Wichita, Kansas
4-11-1961

(If additional description is necessary, use BACK of this sheet)
Name of Plugging Contractor Southwest Casing Pulling Co., Inc.
Address P. O. Box 364, Great Bend, Kansas

STATE OF Kansas COUNTY OF Sedgwick, ss.
J. F. Carter, Jr. (employee of owner) or (owner or operator) of the above-described well, being first duly sworn on oath, says: That I have knowledge of the facts, statements, and matters herein contained and the log of the above-described well as filed and that the same are true and correct. So help me God.

(Signature) J. F. Carter, Jr. Petroleum Engineer
522 Union Center Wichita, Kansas (Address)
April 10th, 1961

SUBSCRIBED AND SWORN TO before me this 10th day of April, 1961

My commission expires May 11, 1963
Marguerite Dickey Notary Public.



Rf

Rupp-Ferguson No.
C/NE SW SE, Section 2
Kingman County, Kansas

Elevation 1589 DF

Commenced: 12-3-58
Completed: 12-15-58
Contractor: Rupp-Ferguson Oil Company

Set 253' of 8 5/8" w/175 sax
Set 4290' of 5 1/2" w/125 sax

Figures Indicate Bottom of Formation

38 sand
44 red rock
44 cement, red bed
600 red bed
885 shale
950 salt and shale
1268 shale and shells
1392 lime and shale
1555 lime and shale streaks
1744 lime, shale and sand streaks
1906 lime, shale and sand streaks
2028 lime
2150 lime and shale
3133 lime, shale and sand
3305 shale, lime, sand streaks
3310 shale and sand
3610 lime and shale
3680 lime
3888 lime
3971 lime and shale
4022 lime
4070 lime
4119 lime and shale
4171 lime and shale
4280 Miss.
4290 T.D.

STATE OF KANSAS)
SEDGWICK COUNTY) SS:

I, L. W. Knox, Partner in Rupp-Ferguson Oil Company, do hereby certify that the above and foregoing is a true and correct copy of the log of the No. 1 Swingle well.


L. W. KNOX

Subscribed and sworn to before me this 18th day of December, 1958.


Notary Public

My Commission Expires June 4, 1959.

RECEIVED
STATE CORPORATION COMMISSION
APR 11 1961
CONSERVATION DIVISION
Wichita, Kansas