


Give All Information Completely
Make Required Affidavit
Mail or Deliver Report to:
Conservation Division
State Corporation Commission
P. O. Box 67027
Wichita, Kansas 67217
NORTH

WELL PLUGGING RECORD

Kingman County, Sec. 2 Twp. 30S Rge. 9 (E) W (W)

Location as "NE/CNW/SW" or footage from lines S/2 SW SW
Lease Owner McGoy Petroleum Company
Lease Name Swingle Well No. 1
Office Address 502 Union Center Bldg., Wichita, Kansas 67202
Character of Well (completed as Oil, Gas or Dry Hole) Dry Hole
Date well completed 4-26 19 74
Application for plugging filed 4-26 19 74
Application for plugging approved 4-26 19 74
Plugging commenced 4-26 19 74
Plugging completed 4-26 19 74
Reason for abandonment of well or producing formation Dry Hole

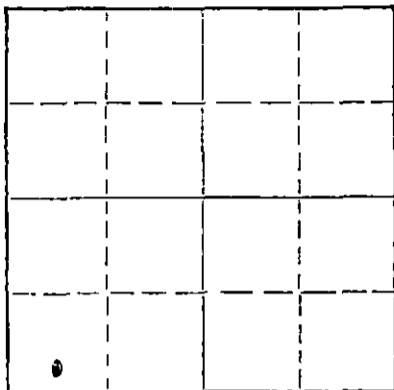

Locate well correctly on above Section Plat

If a producing well is abandoned, date of last production 19
Was permission obtained from the Conservation Division or its agents before plugging was commenced? Yes

Name of Conservation Agent who supervised plugging of this well Russ Bieberstein
Producing formation _____ Depth to top _____ Bottom _____ Total Depth of Well _____ Feet
Show depth and thickness of all water, oil and gas formations.

OIL, GAS OR WATER RECORDS

CASING RECORD

| FORMATION | CONTENT | FROM | TO | SIZE | PUT IN | PULLED OUT |
|--------------|---------|------|-----|--------|--------|------------|
| Surface pipe | | -0- | 270 | 8 5/8" | 270 | None |
| | | | | | | |
| | | | | | | |
| | | | | | | |
| | | | | | | |

Describe in detail the manner in which the well was plugged, indicating where the mud fluid was placed and the method or methods used in introducing it into the hole. If cement or other plugs were used, state the character of same and depth placed, from _____ feet to _____ feet for each plug set.

Filled hole with heavy mud.

#1 Plug set @ 260' with 25sks. cement.

#2 Plug set @ 40' with 10 sks. cement.

#3 Plug set in rat hole with 2 sks. cement.

RECEIVED
STATE CORPORATION COMMISSION
MAY 2 - 1974
CONSERVATION DIVISION
Wichita, Kansas


(If additional description is necessary, use BACK of this sheet)

Name of Plugging Contractor Sweetman Drilling, Inc.
Address Box 645, Great Bend, Kansas 67530

STATE OF Kansas, COUNTY OF Barton, ss.
Gary L. Hawk (employee of owner) or (owner or operator) of the above-described well, being first duly sworn on oath, says: That I have knowledge of the facts, statements, and matters herein contained and the log of the above-described well as filed and that the same are true and correct. So help me God.

(Signature) Gary L. Hawk
Box 645 (Address)

Subscribed and sworn to before me this 1st day of May, 1974
Mary Ann Schwamborn Notary Public.

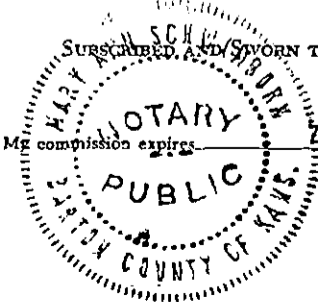

WELL LOG
Swingle #1
S/2 SW SW 2-30S-9W
Kingman County, Kansas

Name of Operator: McCoy Petroleum Company
502 Union Center Bldg.
Wichita, Kansas 67202

Date Completed: April 26, 1974

| FROM | TO | |
|------|------|-------------------|
| 0 | 60 | Sand |
| 60 | 910 | Red bed and shale |
| 910 | 3573 | Shale and lime |
| 3573 | 3665 | Lime |
| 3665 | 4152 | Lime and shale |
| 4152 | 4265 | Lime |
| 4265 | | Total Depth |

RECEIVED
STATE CORPORATION COMMISSION
MAY 2 - 1974
CONSERVATION DIVISION
Wichita, Kansas

STATE OF KANSAS

COUNTY OF BARTON ss

Gary L. Hawk, Secretary of Sweetman Drilling, Inc., being first duly sworn on oath says: That I have knowledge of the facts, statements and matters herein contained and the log of the above described well as filed and that the same are true and correct.

Gary L. Hawk

Gary L. Hawk

Subscribed and sworn before me this 1st day of May, 1974.

Mary Ann Schwamborn

Notary Public Barton County

My Commission Expires 7-10-77

