


STATE OF KANSAS
STATE CORPORATION COMMISSION

Give All Information Completely
Make Required Affidavit
Mail or Deliver Report to:
Conservation Division
State Corporation Commission
800 Bittling Building
Wichita, Kansas

WELL PLUGGING RECORD

Grant _____ County. Sec. 2 Twp. 30S Rge. _____ (E) 36 (W)
Location as "NE/CNW/SW" or footage from lines C SE NW
Lease Owner R. W. Rine Drilling Co., etal
Lease Name Alford Well No. 1
Office Address 420 Union Center, Wichita 2, Kansas
Character of Well (completed as Oil, Gas or Dry Hole) Dry Hole
Date well completed _____ February 8, 19 62
Application for plugging filed _____ February 8, 19 62
Application for plugging approved _____ February 8, 19 62
Plugging commenced _____ February 8, 19 62
Plugging completed _____ February 8, 19 62
Reason for abandonment of well or producing formation Dry Hole

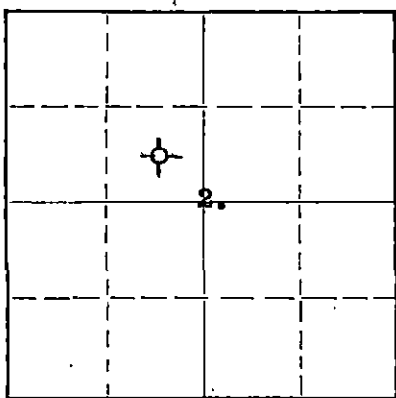

Locate well correctly on above
Section Plat

If a producing well is abandoned, date of last production _____ 19 _____
Was permission obtained from the Conservation Division or its agents before plugging was commenced? Yes

Name of Conservation Agent who supervised plugging of this well W. L. Lac Kamp
Producing formation _____ Depth to top _____ Bottom _____ Total Depth of Well 5877 Feet
Show depth and thickness of all water, oil and gas formations.

OIL, GAS OR WATER RECORDS

CASING RECORD

FORMATION	CONTENT	FROM	TO	SIZE	PUT IN	PULLED OUT
				8-5/8"	1728	-0-

Describe in detail the manner in which the well was plugged, indicating where the mud fluid was placed and the method or methods used in introducing it into the hole. If cement or other plugs were used, state the character of same and depth placed, from _____ feet to _____ feet for each plug set.

Heavy mud from total depth to 2900'
200 sx. common three opening drill pipe from 2900' to 2400'
Heavy mud from 2400' to 550'
Set rubber plug
20 sx. common from 550' to 480'
Heavy mud from 480' to 30'
15 sx. common from 30' to bottom of cellar.

STATE CORPORATION COMMISSION
FEB 11 1962
CONSERVATION DIVISION
2-14-1962

(If additional description is necessary, use BACK of this sheet)
Name of Plugging Contractor K&E Drilling, Inc. and Halliburton
Address 716 Union Center 410 Union Center Wichita, Kansas

STATE OF KANSAS, COUNTY OF SEDGWICK, ss.
R. M. Green (employee of owner) or (owner or operator) of the above-described well, being first duly sworn on oath, says: That I have knowledge of the facts, statements, and matters herein contained and the log of the above-described well as filed and that the same are true and correct. So help me God.

(Signature) R. M. Green
420 Union Center, Wichita 2, Kansas
(Address)

SUBSCRIBED AND SWORN to before me this 12th day of February 19 62

My commission expires 6-14-62
Louis E. Lake Notary Public.



DRILLER'S WELL LOG

OPERATOR: R. W. RINE DRILLING CO., etal
420 Union Center Building
Wichita 2, Kansas

WELL NAME: #1 ALFORD
LOCATION: C SE NW, Sec. 2-30S-36W
Grant County, Kansas

CONTRACTOR: **K & E DRILLING, INC.**
719 UNION CENTER BLDG.
WICHITA, KANSAS

COMMENCED: 1-16-62

CASING RECORD: 8-5/8" @ 1728' w/700 sx.
pozmix & 100 sx. common.

COMPLETED: 2-8-62

ELEVATION: 3015 KB

ROTARY TOTAL DEPTH: 5875'

PRODUCTION: Dry Hole

FORMATION RECORD

Depths shown indicate bottom of formations encountered.

<u>Formation</u>	<u>Depth</u>
Clay	115
Sand & Shale	600
Shale & Red Bed	750
Red Bed	895
Red Bed & Sand	1194
Chalk & Red Bed	1245
Red Bed & Sand	1555
Red Bed	1729
Shale & Lime	1960
Shale	2346
Shale & Lime	2740
Lime	5875 T.D.

RECEIVED
STATE OF KANSAS
FEB 1 1962
CONSERVATION DIVISION
Wichita, Kansas

CERTIFICATION

State of KANSAS }
County of SEDGWICK } ss:

I, Wayne L. Brinegar, of K&E DRILLING, INC., upon oath state that the above and foregoing is a true and correct copy of the Driller's Log of the above named well.

Subscribed and sworn to before me this 12th day of February, 1962

My Commission expires: August 30, 1965

Wayne L. Brinegar
Wayne L. Brinegar
Julene M. Bannon
Julene M. Bannon Notary Public.

