

WELL PLUGGING RECORD

FORMATION PLUGGING RECORD

Strike out upper line when reporting plugging of formations.

STATE OF KANSAS STATE CORPORATION COMMISSION

Give All Information Completely Make Required Affidavit Mail or Deliver Report to: Conservation Division State Corporation Commission 800 Bitting Building Wichita, Kansas

Rice County. Sec. 9 Twp. 21 Rge. 7 W. (E) (W)

NORTH

Section Plat grid table with 4 columns and 4 rows.

Locate well correctly on above Section Plat

Location as "NE1/4NW1/4SW1/4" or footage from lines... Thee Aylward Production Company... Theede... 813 First Natl. Bank Bldg., Wichita, Kansas... Oil... 4-14-37... Dec. 18, 1941... Dec. 23, 1941

If a producing well is abandoned, date of last production... Was permission obtained from the Conservation Division or its agents before plugging was commenced? Yes

Name of Conservation Agent who supervised plugging of this well... Producing formation... Depth to top... Bottom... Total Depth of Well... Feet

OIL, GAS OR WATER RECORDS .

CASING RECORD


Table with 7 columns: Formation, Content, From, To, Size, Put In, Pulled Out.

Describe in detail the manner in which the well was plugged, indicating where the mud fluid was placed and the method or methods used in introducing it into the hole. If cement or other plugs were used, state the character of same and depth placed, from... feet to... feet for each plug set.

3373' to 3360' mud 8 sacks of cement @ 3360' mud to 150' 20 sacks of cement @ 150' mud to 14' 8 sacks of cement @ 14' to base of cellar

Handwritten notes in a box: 9 21 74 14 22

1-6-1942

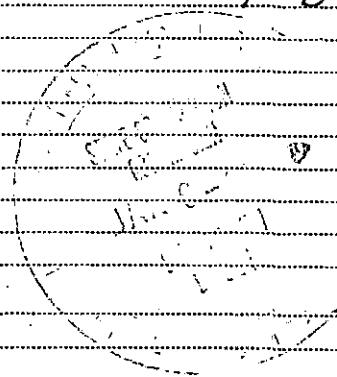

(If additional description is necessary, use BACK of this sheet)

Correspondence regarding this well should be addressed to... Address

STATE OF Kansas, COUNTY OF Sedgwick, ss.

(employee of owner) or (owner or operator) of the above-described well, being first duly sworn on oath, says: That I have knowledge of the facts, statements, and matters herein contained and the log of the above-described well as filed and that the same are true and correct. So help me God.

(Signature) C. L. Steinberg & Co. 809 Ellis-Singleton Bldg., Wichita, Kansas (Address)

Handwritten signature of C. L. Steinberg

Subscribed and Sworn to before me this 27th day of December, 1941.

Handwritten signature of Notary Public

My commission expires Aug. 27, 1946

Notary Public.

L. E. DOUGLAS CO.
Theede No. 4

SEC. 9 T. 21 R. 7W
SWc SW

Total Depth. 3372'
Comm. 3-23-37 Corp. 4-14-37
Shot or Treated.
Contractor. L.E. Douglas
Issued. 6-26-37

County. Rice

CASING:

16" 105'
8-5/8" 3355'

Elevation.

Production. Pot. 2190 B.

Figures Indicate Bottom of Formations.

send	35
shells	105
shale and shells	618
shale and salt	1025
shale and shells	1328
shells	1449
shale and lime shells	1510
shells	1550
shale and shells	1652
shale	1923
shale and lime shells	2043
shale	2179
lime and shale	2249
lime shells and shale	2337
shale	2395
lime	2720
shale	2730
lime	2840
lime	2850
lime shells and shale	2907
lime Kansas City	2955
lime	3275
lime and shale	3355
conglomerate	3372
Total Depth.	

9 21 7W
14 22

Mud between plugs
6 sax at 3350
20 sax at 150
8 sax at base of cellar (No. 4)

