

STATE OF KANSAS
STATE CORPORATION COMMISSION

WELL PLUGGING RECORD

Give All Information Completely
Make Required Affidavit
Mail or Deliver Report to:
Conservation Division
State Corporation Commission
800 Bitting Building
Wichita, Kansas

OR
FORMATION PLUGGING RECORD

Strike out upper line
when reporting plug-
ging of formations.

Rice County, Sec. 9 Twp. 21 Rge. (E) 7 (W)

Location as "NE $\frac{1}{4}$ NW $\frac{1}{4}$ SW $\frac{1}{4}$ " or footage from lines. SW $\frac{1}{4}$ SW $\frac{1}{2}$ SE $\frac{1}{4}$

Lease Owner Mid Plains Oil Corporation

Lease Name John F. Snyder Well No. 2

Office Address 915 Union National Bank Bldg., Wichita, Kansas.

Character of Well (completed as Oil, Gas or Dry Hole) Oil

Date, well completed 10-26- 1937

Application for plugging filed 4-4- 1945

Application for plugging approved 4-6- 1945

Plugging Commenced 5-1- 1945


Plugging Completed 5-7- 1945

Reason for abandonment of well or producing formation

Unable to produce profitably any longer

If a producing well is abandoned, date of last production 11-15- 1942

Was permission obtained from the Conservation Division or its agents before plugging was com-
menced? Yes

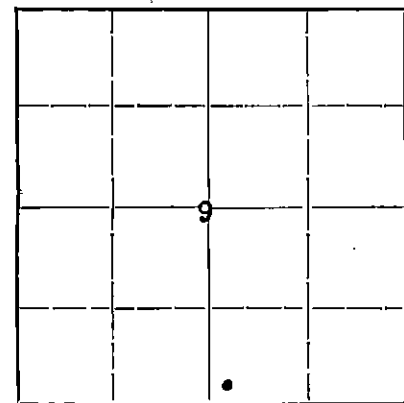

Locate well correctly on above
Section Plat

Name of Conservation Agent who supervised plugging of this well Ruell Durkee

Producing formation Conglomerate Depth to top 3345 Bottom 3374 Total Depth of Well 3379 Feet

Show depth and thickness of all water, oil and gas formations.


OIL, GAS OR WATER RECORDS

CASING RECORD

Formation	Content	From	To	Size	Put In	Pulled Out
Conglomerate	Oil & Gas	3345	3374	13"OD	95'	None
				7"OD	3374'	2600'
				5 $\frac{1}{8}$ "OD	30'	None

Describe in detail the manner in which the well was plugged, indicating where the mud fluid was placed and the method or methods used in introducing it into the hole. If cement or other plugs were used, state the character of same and depth placed, from _____ feet to _____ feet for each plug set.

7 Sacks cement dumped at 3374'. Hole was filled with mud to 150' and 25 sacks cement dumped. Surface pipe was filled with mud and 8 sacks cement put in base of cellar

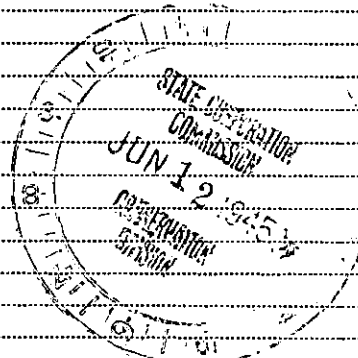

PLUGGING
DATE 9-21-70
BY 9-22

6-12-1945

(If additional description is necessary, use BACK of this sheet)

Correspondence regarding this well should be addressed to Mid Plains Oil Corporation.

Address 915 Union National Bank Bldg., Wichita, Kansas.

STATE OF Kansas, COUNTY OF Sedgwick, ss.

I John W. Ritchey (employee of owner) or (owner or operator) of the above-described well, being first duly sworn on oath, says: That I have knowledge of the facts, statements, and matters herein contained and the log of the above-described well as filed and that the same are true and correct. So help me God

(Signature)

John W. Ritchey

915 Union National Bank Bldg., Wichita, Kansas.
(Address)

SUBSCRIBED AND SWORN to before me this 11th day of June, 1945

Sarotha Starb Carpenter
Notary Public

My commission expires

Jan 13-1949

JOHN F. SNYDER NO. 2 WELL

Sec. 9, TWP. R. 7W,
Rice County, Kansas.

for
Drilled by Mid Plains Oil Corporation,
Drilled by R. E. Garden and Son

Drilling Comm. July 27, 1937
Drilling Comp. October 26, 1937

Elevation 1612'

95' 13" O.D. Cemented with 106 Sacks cement
3378' 7" O.D. " " 125 " "

<u>FORMATION</u>	<u>DEPTH</u>
Sand	64
Red bed rock	90
Lime shell	94
Shale	600
Salt	1000
Shale and shells	1025
Lime and shale	1250
Broken lime	1400
Shale and shells	1465
Lime and shale	1565
Shale and shells	1765
Lime and shale	1845
Shale and shells	2365
Shale and lime	2465
Lime	2705
Shale and shells	2845
Shale	2865
Kansas City lime	2925
Lime	3250
Shale	3280
Shale and lime	3325
Variegated shales	3345
Conglomerate	3348
Shale	3353
Conglomerate and shale	3354
gas and oil	3359
Conglomerate	3379 TD

JUL 19 1937

PLUGGING
FILE SEC 9 T21 R 7W
BOOK PAGE 9 LINE 22