


WELL PLUGGING RECORD

Give All Information Completely
Make Required Affidavit
Mail or Deliver Report to:
Conservation Division
State Corporation Commission
800 Bittling Building
Wichita, Kansas

NORTH

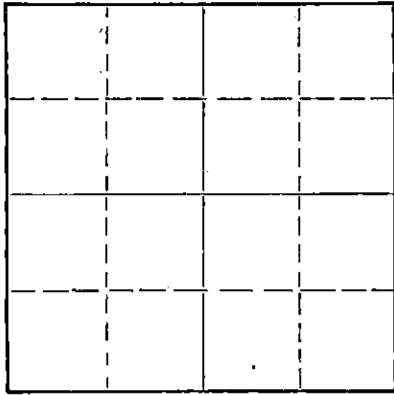

Locate well correctly on above
Section Plat

Rice County, Sec. 9 Twp. 21S Rge. 7W (E) (W)
Location as "NE/CNW%SW%" or footage from lines SEc SW SE
Lease Owner Bennett & Gould
Lease Name Snyder Well No. 1
Office Address Box 31, Augusta, Kansas
Character of Well (completed as Oil, Gas or Dry Hole) Dry Hole
Date well completed September 19, 1955 19
Application for plugging filed October 11, 1955 19
Application for plugging approved October 11, 1955 19
Plugging commenced Oct. 17 19 55
Plugging completed Oct. 21 19 55
Reason for abandonment of well or producing formation dry

If a producing well is abandoned, date of last production none 19
Was permission obtained from the Conservation Division or its agents before plugging was commenced? Yes

Name of Conservation Agent who supervised plugging of this well Ruel Durkee
Producing formation _____ Depth to top _____ Bottom _____ Total Depth of Well 3419 Feet
Show depth and thickness of all water, oil and gas formations.

OIL, GAS OR WATER RECORDS

CASING RECORD

FORMATION	CONTENT	FROM	TO	SIZE	PUT IN	PULLED OUT
				8-5/8"	175	none
				5-1/2"	3353'	2917

Describe in detail the manner in which the well was plugged, indicating where the mud fluid was placed and the method or methods used in introducing it into the hole. If cement or other plugs were used, state the character of same and depth placed, from _____ feet to _____ feet for each plug set.

Filled back with sand to 3340'. Dumped 6 sacks of cement. Shot pipe off at 2917'. Pulled pipe and mudded hole to 170'. Set rock bridge and dumped 15 sacks of cement at 170'. Finished mudding hole and dumped 5 sacks of cement at base of cellar.

(If additional description is necessary, use BACK of this sheet)

Name of Plugging Contractor Bert Self
Address Hutchinson, Kansas

STATE OF Kans. COUNTY OF Reno, ss.
Employee (employee of owner) or (owner or operator) of the above-described well, being first duly sworn on oath, says: That I have knowledge of the facts, statements, and matters herein contained and the log of the above-described well as filed and that the same are true and correct. So help me God.

(Signature) Bert Self
R. R. #4, Hutchinson, Kans.
(Address)

SUBSCRIBED AND SWORN TO before me this 21st day of October, 19 55

My commission expires August 12, 1957

Dorothy Self
Notary Public.

PLUGGING
FILE SEC-9 T21 R2W
BOOK PAGE 2 LINE 25

11-3-1955

SNYDER #1 ROTARY DRILLER'S LOG

Snyder #1

Elevation: 1609 D. F.

Legal Description:

SE SW SE 9-21-7W

Casing Record: 175 8 5/8 with
150 sacks Pozmix 2% ce cement circulated
3353' of 5 1/2" with 75 sacks pozmix

Operator: Bennett & Gould
Wichita, Kansas.

Contractor: Salina Drilling Corp., Inc.
Box #566,
Salina, Kansas.

Well Commenced: 9-10-55

Geologist: R. C. Armstrong
Rule Building,
Wichita, Kansas.

Well Completed: 9-19-55

Clay	20
Sand	50
Red Bed and Shells	175
Red Bed	765
Shale and Shells	1160
Lime and Shale	1525
Lime	1585
Lime and Shale	2280
Lime, Shale, and Sand	2420
Lime and Shale	2500
Lime	2770
Lime & Shale	3170
Lime	3280
Lime & Shale	3356

RECEIVED
STATE CORPORATION COMMISSION
SEP 26 1955
CONSERVATION DIVISION
Wichita, Kansas
RECEIVED
STATE CORPORATION COMMISSION
OCT 22 1955

TOPS AS PICKED BY GEOLOGIST CONSERVATION DIVISION
Wichita, Kansas

Conglomerate 3325' Chert. Conglomerate 3350'

The above rotary driller's log is complete and correct to the best of my knowledge.

Loren J. Hallam

Subscribed and sworn to before me this 23rd day of September, 1955

Fern M. Cullough

Notary Public

My commission expires 2-26-58

PLUGGING
 SEC 9-21-7W
 BOOK PAGE 2 LINE 25