


WELL PLUGGING RECORD

Give Information Completely
Make Sure Affidavit
Mail of Report to:
Conservation Division
State Corporation Commission
800 Blitting Building
Wichita, Kansas

NORTH

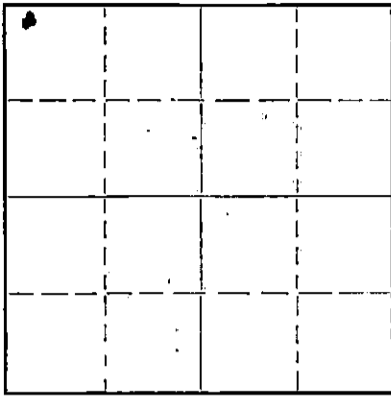

Locate well correctly on above
Section Plat

Rice County. Sec. 9 Twp. 21 Rge. 7 (X) (W)
Location as "NE/CNW/4SW 1/4" or footage from lines: NW NW NW
Lease Owner Sage, Yankey & Helling
Lease Name John Gossman Well No. 7
Office Address Box 551, Eldorado, Kansas
Character of Well (completed as Oil, Gas or Dry Hole) Oil
Date well completed 7-25-1937
Application for plugging filed 12-10-1948
Application for plugging approved 12-12-1948
Plugging commenced 2-6-1949
Plugging completed 2-13-1949
Reason for abandonment of well or producing formation:
Producing 98% water
If a producing well is abandoned, date of last production 11-17-1948
Was permission obtained from the Conservation Division or its agents before plugging was commenced? Yes

Name of Conservation Agent who supervised plugging of this well R. Durkee
Producing formation Depth to top Bottom Total Depth of Well 3352' Feet
Show depth and thickness of all water, oil and gas formations.

OIL, GAS OR WATER RECORDS

CASING RECORD

Formation	Content	From	To	Size	Put In	Pulled Out
				8-5/8"		2622'

Describe in detail the manner in which the well was plugged, indicating where the mud fluid was placed and the method or methods used in introducing it into the hole. If cement or other plugs were used, state the character of same and depth placed, from feet to feet for each plug set.

Run 10 sacks of cement at 3352', mudded up to 103'. Set bridge and run 30 sacks of cement at 103'. Mudded up to 15'. Then run 10 sacks of cement to cap.

2-19-1949

RECEIVED
Conservation Div.
FEB 19 1949
STATE CORPORATION COMMISSION
KANSAS

(If additional description is necessary, use BACK of this sheet)
Correspondence regarding this well should be addressed to Sage, Yankey & Helling
Address Box 551 Eldorado, Kansas

STATE OF KANSAS, COUNTY OF RUSSELL, ss.
Sam L. Roberson (employee of owner) or (owner/operator) of the above-described well, being first duly sworn, on oath, says: That I have knowledge of the facts, statements, and matters herein contained and the log of the above-described well as filed and that the same are true and correct. So help me God.

(Signature) Sam L. Roberson
Box 415 Russell, Kansas (Address)

SUBSCRIBED AND SWORN to before me this 18 day of February, 1949
Verrel J. Brack Notary Public.

My commission expires 10-13-52

PLUGGING
FILE SEC 9 T 21 R 7W
BOOK PAGE 73 LINE 9


SAGE, YANKEY & HELLING
% Eldorado Refining Co.

Sec. 9 - 21 - 7W
NW NW NW

JOHN GOSSMAN #7

Total Depth: 3352'
Comm: 6-27-37 Comp: 7-25-37
Shot or treated.
Contractor: Stearns & Walker
Issued: 9-4-37

COUNTY: Rice

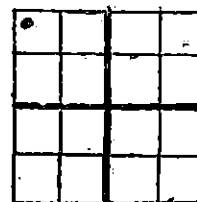

Elevation:

Prod. Pot: 4950 Bbls.

Figures indicate bottom of Formations.

Surface Hole	103
Red rock & shale	521
Shale, shells & salt	855
Shale & shells	1025
Broken Lime	1060
Shale & shells	1253
Broken Lime	1308
Shale & shells	1350
Sand	1387
Shale & shells	1474
Broken Lime	1560
Shale & Shells	1950
Broken Lime	1980
Shale & shells	2343
Lime	2360
Shale	2400
Lime	2599
Lime & shale	2662
Lime	2730
Broken Lime	2773
Shale	2784
Lime	2821
Shale & Shells	2889
Broken Lime	2945
Lime	2995
Shale	3005
Lime	3200
Lime & shale	3262
Shale & Shells	3345
Red Rock	3351
Pay Conglomerate	3352'

Well Log Bureau Kansas Geological Society

