


WELL PLUGGING RECORD

Give All Information Completely
Make Required Affidavit
Mail or Deliver Report to:
Conservation Division
State Corporation Commission
800 Bittling Building
Wichita, Kansas

Rice County, Sec. 9 Twp. 21 Rge. 7 ~~W~~ (W)

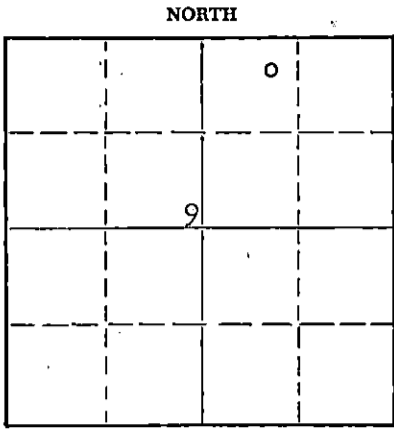

Locate well correctly on above Section Plat

Location as "NE/CNW%SW%" or footage from lines NE NW NE
Lease Owner Petroleum, Incorporated
Lease Name DeWees "B" Well No. 1
Office Address 311 East Third, Wichita, Kansas
Character of Well (completed as Oil, Gas or Dry Hole) Oil
Date well completed January 2 19 51
Application for plugging filed April 26 19 56
Application for plugging approved May 16 19 56
Plugging commenced May 17 19 56
Plugging completed May 19 19 56
Reason for abandonment of well or producing formation Depletion of Producing Zones.

If a producing well is abandoned, date of last production April 24 19 56
Was permission obtained from the Conservation Division or its agents before plugging was commenced? Yes

Name of Conservation Agent who supervised plugging of this well Ruel Durkee, McPherson, Kansas
Producing formation Conglomerate Depth to top 3341' Bottom ---- Total Depth of Well 3353.5 Feet
Show depth and thickness of all water, oil and gas formations.

OIL, GAS OR WATER RECORDS

CASING RECORD

FORMATION	CONTENT	FROM	TO	SIZE	PUT IN	PULLED OUT
Conglomerate (open hole)	Water &			8-5/8" OD	137'	None
	Oil	3341'	3353.5'	5-1/2" OD	3341'	2825'

Describe in detail the manner in which the well was plugged, indicating where the mud fluid was placed and the method or methods used in introducing it into the hole. If cement or other plugs were used, state the character of same and depth placed, from _____ feet to _____ feet for each plug set.

Filled hole with crushed rock from 3353.5' to 3330', and placed 6 sacks of cement on top of rock. Mudded up to 130' and made solid rock bridge on top of mud. Placed 15 sacks cement on to rock bridge and mud up to 15'. Made solid rock bridge at 15' and filled hole to base of well cellar with 5 sacks of cement.

6-9-1956

(If additional description is necessary, use BACK of this sheet)

Name of Plugging Contractor Morgan Well Plugging Service
Address 102 West 18th Street, Hutchinson, Kansas

STATE OF KANSAS, COUNTY OF BARTON, ss.
DON SEARLE (employee of owner) or (owner or operator) of the above-described well, being first duly sworn on oath, says: That I have knowledge of the facts, statements, and matters herein contained and the log of the above-described well as filed and that the same are true and correct. So help me God.

(Signature) Don Searle
Route 2, Great Bend, Kansas
(Address)

SUBSCRIBED AND SWORN TO before me this 4th day of June, 19 56

My commission expires November 21, 1957
Jay E. Anderson Notary Public.

PLUGGING
FILE SEC 9 T. 21 R. 7W
BOOK PAGE 57 LINE 16

DE WESS "B" #1

Casing Record:-
 8-5/8" - 138'
 5-1/2" - 3341'

Company - Petroleum, Inc.,
 Contractor - Ayward Drilg. Co.

Description:-
 NE 1/4 NW 1/4 NE 1/4 of
 Section 9-21S-7N
 Rice Co., Kansas.

Commenced - December 8, 1950
 Completed - December 21, 1950

Elevation -

<u>Formation</u>	<u>From</u>	<u>To</u>	<u>Remarks</u>
Surface	0	138	Set 8-5/8" casing at 138', and cemented w/ 125 sax.
Shale and shells	138	700	
Salt, shale & shells	700	1050	
Shale and shells	1050	1235	
Lime and shale	1235	1293	
Lime sandy	1293	1370	
Lime	1370	1400	
Lime and shale	1400	1675	
Lime	1675	1710	
Lime and shale	1710	1875	
Shale and shells	1875	2100	
Shale	2100	2285	
Lime and shale	2285	2405	
Lime	2405	3230	
Lime and shale	3230	3320	
Lime	3320	3343	- 5 1/2" Set at 3341' and cemented with 85 sax.
			3343 - T.D.

I certify that this is a true and correct copy of the drillers log to the best of my knowledge.

M. Szalsky
 M Szalsky

Subscribed and sworn to before me this 26th day of December, 1950.

Samuel H. Higgens
 Notary Public

My commission expires April 6, 1951.

RECEIVED
 DIVISION OF OIL AND GAS
 JUNE 19 1951
 DIVISION

PLUGGING
 FILE SEC 9 T 21 R 7W
 BOOK PAGE 57 1 16