


STATE OF KANSAS
STATE CORPORATION COMMISSION

Give All Information Completely
Make Required Affidavit
Mail or Deliver Report to:
Conservation Division
State Corporation Commission
800 Bittling Building
Wichita, Kansas

WELL PLUGGING RECORD

NORTH

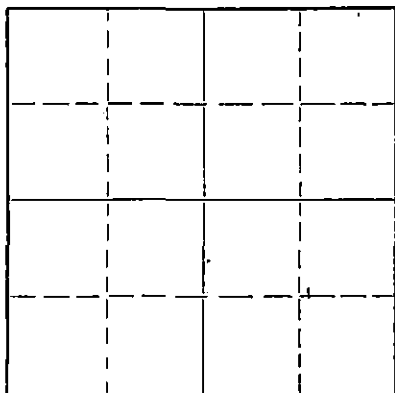

Locate well correctly on above
Section Plat

RUSH

County. Sec. 1 Twp. 16S Rge. 19 (E) W(W)

Location as "NE/CNW/SW" or footage from lines NE NE NE

Lease Owner Shelley-Miller Drilling, Inc.

Lease Name Werth

Well No. 1

Office Address 205 Miller Bldg, Wichita, Kansas

Character of Well (completed as Oil, Gas or Dry Hole) Dry Hole

Date well completed August 10 19 53

Application for plugging filed August 11 19 53

Application for plugging approved August 11 19 53

Plugging commenced August 11 19 53

Plugging completed August 11 19 53

Reason for abandonment of well or producing formation

No Commercial Show

If a producing well is abandoned, date of last production 19

Was permission obtained from the Conservation Division or its agents before plugging was commenced? Yes

Name of Conservation Agent who supervised plugging of this well C. D. Stough

Producing formation Depth to top Bottom Total Depth of Well 3610 Feet

Show depth and thickness of all water, oil and gas formations.

OIL, GAS OR WATER RECORDS

CASING RECORD

FORMATION	CONTENT	FROM	TO	SIZE	PUT IN	PULLED OUT
				8 5/8	1172	None

Describe in detail the manner in which the well was plugged, indicating where the mud fluid was placed and the method or methods used in introducing it into the hole. If cement or other plugs were used, state the character of same and depth placed, from feet to feet for each plug set.

Bottom Plug @ 270' Cemented with 20 Sacks

Top Plug @ 35' Cemented with 10 Sacks

RECEIVED
STATE CORPORATION COMMISSION

AUG 15 1953

CONSERVATION DIVISION
Wichita, Kansas

8-15-1953

(If additional description is necessary, use BACK of this sheet)

Name of Plugging Contractor

Address

STATE OF KANSAS, COUNTY OF SEDGWICK, ss.

Richard A. Shelley (employee of owner) or (owner or operator) of the above-described well, being first duly sworn on oath, says: That I have knowledge of the facts, statements, and matters herein contained and the log of the above-described well as filed and that the same are true and correct. So help me God.

(Signature)

Richard A. Shelley President

205 Miller Bldg, Wichita, Kansas

(Address)

SUBSCRIBED AND SWORN to before me this 13 day of August, 19 53

My commission expires March 24, 1956

Notary Public.

PLUGGING
FILE SEC 1 T 16 R 1944
BOOK PAGE 12 / LINE 11

COMPANY: Shelley-Miller Drilling, Inc
205 Miller Building
Wichita, Kansas

Rotary Drilling Commenced: 7-28-53
Rotary Drilling Completed: 8-10-53

LOCATION: Werth No. 1
NE NE NE 1-16S-19W
Rush County, Kansas

CONTRACTOR: Shelley-Miller Drilling, Inc
205 Miller Building
Wichita, Kansas

CASING RECORD: 8 5/8" 24# Slms Casing set @ 1172'
Cemented with 500 sacks of cement.

L O G

(Measurements from Top of Rotary Bushing to Bottom of Formation)

Rock	40
Shale & Shells	230
Shale & Rock	280
Shale & Shells	455
Shale	490
Hard Sand	575
Sand	840
Red Bed	1060
Hard Sand	1090
Red Bed	1175
Anhydrite	1210
Shale	1255
Shale & Shells	1575
Lime & Shale	1635
Shale & Shells	1860
Lime	2550
Lime & Shale	2970
Lime	3610

Rotary T. D.

The undersigned, Richard A. Shelley, President of Shelley-Miller Drilling, Inc., hereby certifies in behalf of said company, that the above log is a true and correct log of the formation encountered in drilling the above well as reflected by the Daily Drilling Reports.

SHELLEY-MILLER DRILLING, INC

By

Richard A. Shelley
President

STATE OF KANSAS)
COUNTY OF SEDGWICK) SS

BE IT REMEMBERED that, on this 13th day of August, 1953, before me the undersigned, a Notary Public, duly commissioned in and for the county and state aforementioned, came Richard A. Shelley, President, and known to me to be the same person who executed the foregoing instrument of writing in behalf of Shelley-Miller Drilling, Inc., as President of said company, and he duly acknowledged the execution of the same for himself and for said company.

IN WITNESS WHEREOF, I have hereunto set my hand and official seal on the day and year last above written.

Leona M. Baker
Notary Public

My Commission Expires:
March 24, 1956

PLUGGING
FILE SEC L 16-R 194
BOOK PAGE 12 LINE 11

RECEIVED
STATE CORPORATION

AUG 13 1953

CONSERVATION DEPT
Wichita, Kansas