


STATE OF KANSAS
STATE CORPORATION COMMISSION
CONSERVATION DIVISION
P. O. BOX 17027
WICHITA, KANSAS 67217

FORM CP-4

WELL PLUGGING RECORD

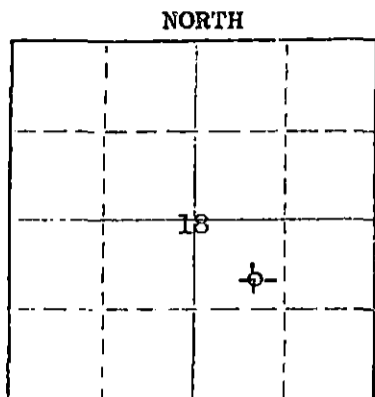

Locate well correctly on above
Section Plat

Kiowa County. Sec. 18 Twp. 28S Rge. 19W (Box) (W)
Location as "NE/CNW/SW" or footage from lines SE NW SE
Lease Owner Dyco Petroleum Corporation
Lease Name Olsen Well No. 1
Office Address 1700 Philtower Building, Tulsa, Oklahoma 74103
Character of Well (completed as Oil, Gas or Dry Hole) Dry Hole
Date well completed February 23, 1975
Application for plugging filed February 23, 1975
Application for plugging approved February 23, 1975
Plugging commenced February 23, 1975
Plugging completed February 23, 1975
Reason for abandonment of well or producing formation Dry Hole

If a producing well is abandoned, date of last production 19
Was permission obtained from the Conservation Division or its agents before plugging was commenced? Yes

Name of Conservation Agent who supervised plugging of this well
Producing formation Depth to top Bottom Total Depth of Well 5000 feet
Show depth and thickness of all water, oil and gas formations.

OIL, GAS OR WATER RECORDS

CASING RECORD

FORMATION	CONTENT	FROM	TO	SIZE	PUT IN	PULLED OUT
		0'	434'	8-5/8"	434'	None

Describe in detail the manner in which the well was plugged, indicating where the mud fluid was placed and the method or methods used in introducing it into the hole. If cement or other plugs were used, state the character of same and depth placed, from feet to feet for each plug set.

5000'-350' - Hole filled with mud & hulls.
350'-346' - Plug
346'-40' - Cement, 35 sacks.
40'-36' - Plug
36'-6' - Cement, 15 sacks. (bottom of cellar)
2 sacks cement in rat hole.

(If additional description is necessary, use BACK of this sheet)

Name of Plugging Contractor Halliburton Cementing Co.
Address Great Bend, Kansas

STATE OF KANSAS COUNTY OF SEDGWICK, ss.
John D. Knightley, Agent ~~employee~~ of owner) or (owner or operator) of the above-described well, being first duly sworn on oath, says: That I have knowledge of the facts, statements, and matters herein contained and the log of the above-described well as filed and that the same are true and correct. So help me God.

(Signature) [Signature]
301 S. Broadway, Wichita, Kansas
(Address)

SUBSCRIBED AND SWORN TO before me this 28th day of February, 1975

My commission expires March 12, 1975
[Signature] Notary Public.

RECEIVED
STATE CORPORATION COMMISSION
MAR 3 1975
CONSERVATION DIVISION
Wichita, Kansas

Dyco Petroleum Corporation - Olsen #1
 SE NW SE Sec. 18-28S-19W
 Kiowa County, Kansas

Contractor: D. R. Lauck Oil Company, Inc.
 301 S. Broadway
 Wichita, Kansas 67202

Commenced: February 10, 1975
 Completed: February 23, 1975

Drillers Log

Clay	80
Sand	130
Shale	515
Sand	575
Shale	1267
Anhydrite	1284
Shale	1585
Shale & Lime	1690
Shale	2075
Lime & Shale	2745
Shale & Lime	3320
Shale	3520
Lime	3690
Lime & Shale	3910
Shale & Shells	4170
Lime	5000 RTD

RECEIVED
 STATE CORPORATION COMMISSION
 MAR 3 1975
 CONSERVATION DIVISION
 Wichita, Kansas