

STATE OF KANSAS  
STATE CORPORATION COMMISSION

Give All Information Completely  
Make Required Affidavit  
Mail or Deliver Report to:  
Conservation Division  
State Corporation Commission  
211 No. Broadway  
Wichita, Kansas

WELL PLUGGING RECORD

Mc Pherson

County. Sec. 29 Twp. 21 Rge. 1 (E) W (W)

Location as "NE/CNW%SW%" or footage from lines 2310' f/s 990' f/e

Lease Owner Jenkins-Ray Supply

Lease Name Boechner Well No. 2

Office Address Box 967, Ponca City, Okla.

Character of Well (completed as Oil, Gas or Dry Hole)

Date well completed 19

Application for plugging filed 19

Application for plugging approved 19


Plugging commenced 4-22 19 62

Plugging completed 4-28 19 62

Reason for abandonment of well or producing formation Depleted

If a producing well is abandoned, date of last production 19

Was permission obtained from the Conservation Division or its agents before plugging was commenced? Yes

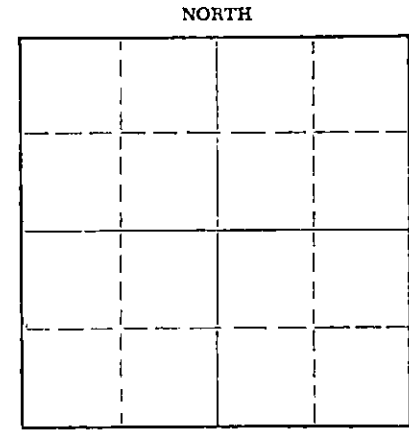

Locate well correctly on above Section Plat

Name of Conservation Agent who supervised plugging of this well Cecil Jones

Producing formation Depth to top Bottom Total Depth of Well Feet

Show depth and thickness of all water, oil and gas formations.

OIL, GAS OR WATER RECORDS

CASING RECORD

FORMATION	CONTENT	FROM	TO	SIZE	PUT IN	PULLED OUT
				10 3/4"	135'	None
				6 5/8"	3325'	2201'

Describe in detail the manner in which the well was plugged, indicating where the mud fluid was placed and the method or methods used in introducing it into the hole. If cement or other plugs were used, state the character of same and depth placed, from feet to feet for each plug set.

Dumped gravel to 2915' and 7 sacks of cement to 2901'  
Set bridge with rock from 150'-140' cement to surface.  
Shot pipe at 2201'

5-29-1962

RECEIVED  
STATE CORPORATION COMMISSION

MAY 29 1962

CONSERVATION DIVISION  
Wichita, Kansas

(If additional description is necessary, use BACK of this sheet)

Name of Plugging Contractor Albert Leach

Address Sterling, Colorado

STATE OF Oklahoma COUNTY OF Kay, ss.  
G.T. Ray Partner

(employee of owner) or (owner or operator) of the above-described well, being first duly sworn on oath, says: That I have knowledge of the facts, statements, and matters herein contained and the log of the above-described well as filed and that the same are true and correct. So help me God.

(Signature) *G.T. Ray*

Box 967, Ponca City, Oklahoma

(Address)

SUBSCRIBED AND SWORN TO before me this 28th day of May 19 62

*Naomi Baker*

My commission expires 8-3-63

Notary Public.



BOECHNER #2

15.113.04575.0000



Drilling started 10-9-37 finished 10-24-37  
Date first prod. 11-5-37  
Located 330'S & 990' W. of E-1/4 corner Sec 29 Twp21s R-1 W Merikson Tomb  
Elevation Derrick floor 1434  
Character of well - Oil

Horton line 3296 to 3331

10" amount set 135' 2" cemented w/150 sacks-Halliburton  
7" 2 1/2" 10thd. " 3325' 0" " 300 " "

Rotary tools 0 to 3298  
Cable tools 3298' to 3331'

Production 1st 24 hrs 643 barrels.

FORMATION RECORD.

Clay	0	5
Sand	5	20
Shale & shells	20	452 300 135' 2" of 10" at 143' cased. 150 sacks
Broken lime	452	580
Shale & shells	580	712
Broken lime	712	712
Shale & shells	318	1257
Shale	1257	1387
Shale & shells	1387	1500 Broken line
Broken lime	1600	1729
Lime	1929	2090
Broken lime	2090	2190
Shale	2190	2302
Lime	2202	2700
Broken lime	2700	2769
Shale & shells	2769	2900
Chert	2900	2927
Chat	2927	3017
Chert	3017	3041
Chat	3041	3060
Hard lime	3060	3141
Lime	3141	3243
Shale	3243	3296
lime (Horton)	3296	3331

RECEIVED  
STATE CORPORATION COMMISSION  
APR 10 1962  
CONSERVATION DIVISION  
Wichita, Kansas

Set 3325' of 7" casing at 3298  
cemented w/300 sacks

- 3298 - 3301 showing of oil
- 3301-3306 - 600' oil in hole
- 3306 - 3311 - 1200' oil in hole
- 3311 - 3316' 2000' oil in hole

0