

STATE OF KANSAS
STATE CORPORATION COMMISSION
Give All Information Completely
Make Required Affidavit
Mail or Deliver Report to:
Conservation Division
State Corporation Commission
211 No. Broadway
Wichita, Kansas

WELL PLUGGING RECORD

McPherson County, Sec. 29 Twp. 21S Rge. 1 (E) (W) X

Location as "NE/CNW/SW" or footage from lines 2310' from NL, 1650' from WL

Lease Owner Forbes Casing Pulling, Inc.

Lease Name Hetzke Well No. 10

Office Address P. O. Box 221 Great Bend, Kansas

Character of Well (completed as Oil, Gas or Dry Hole)

Date well completed 19

Application for plugging filed 3-13-64 19

Application for plugging approved 3-17-64 19


Plugging commenced 3-22-64 19

Plugging completed 3-27-64 19

Reason for abandonment of well or producing formation Dry

If a producing well is abandoned, date of last production 19

Was permission obtained from the Conservation Division or its agents before plugging was commenced? Yes

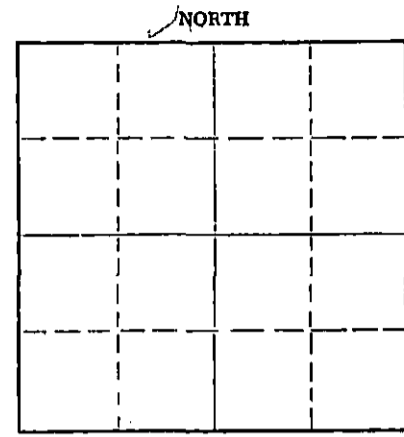

Locate well correctly on above Section Plat

Name of Conservation Agent who supervised plugging of this well Cecil M. Jones

Producing formation Depth to top Bottom Total Depth of Well 3316 Feet

Show depth and thickness of all water, oil and gas formations.

OIL, GAS OR WATER RECORDS

CASING RECORD

FORMATION	CONTENT	FROM	TO	SIZE	PUT IN	PULLED OUT
				10 3/4	1 1/8	None
				7	None	22 1/4'

Describe in detail the manner in which the well was plugged, indicating where the mud fluid was placed and the method or methods used in introducing it into the hole. If cement or other plugs were used, state the character of same and depth placed, from feet to feet for each plug set.

- Cleaned out cellar.
- Working pipe.
- Working pipe. Shot at 2230'.
- Working pipe. Pulling pipe.
- Pulling pipe.
- Plugging well. Build rock bridge at 150' and 3 yards of ready mix cement.

RECEIVED
STATE CORPORATION COMMISSION

APR 1 1964

4-1-64
CONSERVATION DIVISION
Wichita, Kansas

(If additional description is necessary, use BACK of this sheet)

Name of Plugging Contractor Forbes Casing Pulling, Inc.

Address P. O. Box 221 Great Bend, Kansas

STATE OF Kansas COUNTY OF Barton, ss.
J. O. Forbes (employee of owner) or (owner or operator) of the above-described well, being first duly sworn on oath, says: That I have knowledge of the facts, statements, and matters herein contained and the log of the above-described well as filed and that the same are true and correct, So help me God.

(Signature) J. O. Forbes
P. O. Box 221 Great Bend, Kansas (Address)

SUBSCRIBED AND SWORN to before me this 31 day of March, 1964

My commission expires May 27, 1964

Notary Public.

