


WELL PLUGGING RECORD

Give All Information Completely
Make Required Affidavit
Mail or Deliver Report to:
Conservation Division
State Corporation Commission
212 North Market, Insurance Bldg.
Wichita, Kansas

McPherson County. Sec. 29 Twp. 21 Rge. 1 (E) 1 (W)

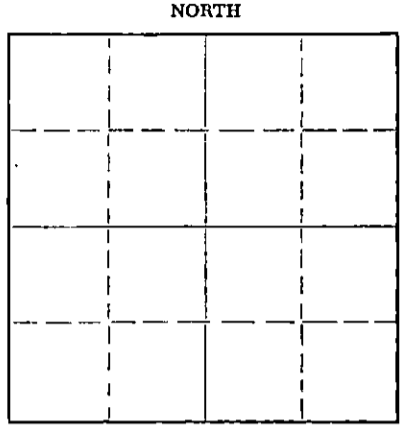

Locate well correctly on above Section Plat

Location as "NE/CNW/SW" or footage from lines C W/2 W/2 SW
Lease Owner Continental Oil Company
Lease Name J. C. Goering Well No. 12
Office Address Box 267, Great Bend, Kansas 67530
Character of Well (completed as Oil, Gas or Dry Hole) _____
Date well completed _____ 19____
Application for plugging filed _____ 19____
Application for plugging approved _____ 19____
Plugging commenced _____ 6-16 19 67
Plugging completed _____ 6-23 19 67
Reason for abandonment of well or producing formation _____

If a producing well is abandoned, date of last production _____ 19____
Was permission obtained from the Conservation Division or its agents before plugging was commenced? Yes

Name of Conservation Agent who supervised plugging of this well Hugh E. Scott
Producing formation _____ Depth to top _____ Bottom _____ Total Depth of Well 3281 Feet
Show depth and thickness of all water, oil and gas formations.

OIL, GAS OR WATER RECORDS				CASING RECORD		
FORMATION	CONTENT	FROM	TO	SIZE	PUT IN	PULLED OUT
				10 3/4	152'	None
				5 1/2	3298'	None

Describe in detail the manner in which the well was plugged, indicating where the mud fluid was placed and the method or methods used in introducing it into the hole. If cement or other plugs were used, state the character of same and depth placed, from _____ feet to _____ feet for each plug set.

Dumped 2 buckets of rock and one bucket of sand. Dumped one bucket of rock and bridged hole at 94'.
Plugged well with 3 yards of ready-mix cement.

FILED
AUG 1 1967
8-1-67
CONSERVATION DIVISION
Wichita, Kansas

(If additional description is necessary, use BACK of this sheet)
Name of Plugging Contractor Continental Oil Company
Address Box 267, Great Bend, Kansas 67530

STATE OF Kansas, COUNTY OF Barton, ss.
L. E. Powell (employee of owner) or (owner or operator) of the above-described well, being first duly sworn on oath, says: That I have knowledge of the facts, statements, and matters herein contained and the log of the above-described well as filed and that the same are true and correct. So help me God.

(Signature) [Signature]
Box 267, Great Bend, Kansas 67530
(Address)

SUBSCRIBED AND SWORN to before me this 27th day of July, 1967
[Signature]
Kenneth J. Querry Notary Public.
My commission expires August 16, 1967




640 Acres
N

15.113.02039.0000

P.O. Drawer 1068
Ponca City, Oklahoma

Form 1002

WELL RECORD

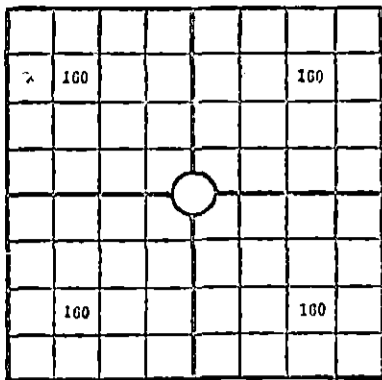

Locate Well Correctly

Mail to Corporation Commission, Oklahoma City, Oklahoma

COUNTY McPherson, SEC. 29, TWP. 21S, RGE. 1W
 COMPANY OPERATING Continental Oil Company
 OFFICE ADDRESS Ponca City, Oklahoma
 FARM NAME J. C. Goering WELL NO. #12
 DRILLING STARTED Oct. 13, 1941, DRILLING FINISHED Nov. 4, 1941
 DATE OF FIRST PRODUCTION COMPLETED
 WELL LOCATED 330' East and 1320' North of SW corner
 Line and of above section ft. East of West Line of Quarter Section
 Elevation (Relative to sea level) DERRICK FLOOR 1472 GROUND
 CHARACTER OF WELL (Oil, gas or dryhole) Oil

OIL OR GAS SANDS OR ZONES

Name	From	To	Name	From	To
1 <u>Hunton Lime</u>	<u>3260</u>	<u>3278</u>	4		
2			5		
3			6		

WATER SANDS

Name	From	To	Water level	Name	From	To	Water level
1				4			
2				5			
3				6			

CASING RECORD

Size	Wt.	Thds.	Make	Amount Set		Set AT		Packer Record			
				Ft.	In.	Ft.	In.	Size	Length	Depth Set	Make
<u>10 3/4"</u>	<u>40</u>	<u>8</u>	<u>Lap</u>	<u>152</u>	<u>3</u>	<u>156'</u>					
<u>5 1/2"</u>	<u>20</u>	<u>10</u>	<u>Smls</u>	<u>1113</u>	<u>6)</u>	<u>(3261'</u>					
<u>5 1/2"</u>	<u>17</u>	<u>10</u>	<u>Lap</u>	<u>2185</u>	<u>6)</u>						

RECEIVED
 OIL & GAS CORPORATION COMMISSION
 APR 11 1967
 CONSERVATION DIVISION
 Oklahoma, Kansas

Liner Record: Amount..... Kind..... Top.....

CEMENTING AND MUDDING

Size	Amount Set		Sacks Cement	Chemical		Method of Cementing	Amount	Mudding Method	Results (See Note)
	Ft.	In.		Gal.	Make				
<u>10 3/4"</u>	<u>152</u>	<u>3</u>	<u>150</u>						
<u>5 1/2"</u>	<u>3299</u>	<u>0</u>	<u>600</u>						

Note: What method was used to protect sands when outer strings were pulled? Not pulled

NOTE: Were bottom hole plugs used? None. If so, state kind, depth set and results obtained

TOOLS USED

Rotary tools were used from 0 feet to 3264 feet, and from feet to
 Cable tools were used from 3264 feet to 3278 feet, and from feet to
 Type Rig

PRODUCTION DATA

Production first 24 hours 404 oil on state potential - no water per cent., Water..... per cent.
 Production second 24 hours..... bbls. Gravity....., Emulsion..... per cent., Water..... per cent.
 If gas well, cubic per 24 hours..... Rock Pressure: Lbs. per square inch

I, the undersigned, being first duly sworn upon oath, state that this well record is true, correct and complete according to the records of this office and to the best of my knowledge and belief.

JPN;hw
 11-24-41

J. C. Goering
 Name and title of representative of company

LPC Subscribed and sworn to before me this..... day of....., 194.....

GEOL-GULF-OHIO-FILE

My Commission expires.....

Notary Public

FORMATION RECORD

Give detailed description and thickness of all formations drilled through and contents of sand, whether dry, water, oil or gas.

Formation	Top	Bottom	Formation	Top	Bottom
Shale	0	45			
Sand	45	90			
Shale & Shells	90	157			
Shale	157	217			
Shale & Shells	217	520			
Broken Lime	520	855			
Shale & Shells	855	1011			
Shale	1011	1334			
Shale & Shells	1334	1599			
Broken Lime	1599	1658			
Shale & Shells	1658	1808			
Lime	1808	1980			
Shale & Shells	1980	2203			
Broken Lime	2203	2237			
Lime	2237	2312			
Shale & Shells	2312	2380			
Lime	2380	2632			
Broken Lime	2632	2682			
Shale	2682	2900			
Chat	2900	3060			
Lime	3060	3200			
Shale (Soft)	3200	3210			
Shale	3210	3260			
Lime Hunton	3260	3281			
T.D. Corrected to ground level		3278			

Corrected for rotary table

RECEIVED
 CONSERVATION DIVISION
 APR 11 1967

