

WELL PLUGGING RECORD

Give All Information Completely
Make Required Affidavit
Mail or Deliver Report to:
Conservation Division
State Corporation Commission
211 No. Broadway
Wichita, Kansas

McPherson County, Sec. 29 Twp. 21S Rge. 7 (E) (W) X

Location as "NE/CNW/SW" or footage from lines 2310' E/S 330' E/W

Lease Owner Forbes Casing Pulling, Inc.

Lease Name J. C. Goering Well No. 11

Office Address P. O. Box 221 Great Bend, Kansas

Character of Well (completed as Oil, Gas or Dry Hole)

Date well completed 19

Application for plugging filed 3-13-64 19

Application for plugging approved 3-17-64 19

Plugging commenced 5-12-64 19


Plugging completed 5-22-64 19

Reason for abandonment of well or producing formation

Dry

If a producing well is abandoned, date of last production 19

Was permission obtained from the Conservation Division or its agents before plugging was commenced? Yes

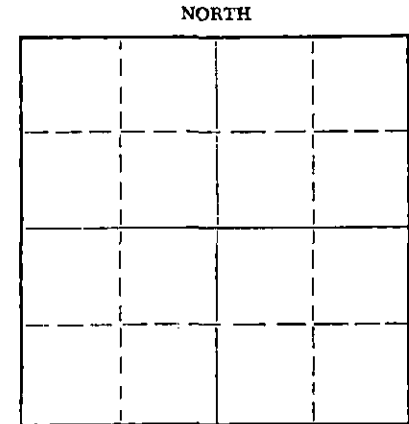

Locate well correctly on above Section Flat

Name of Conservation Agent who supervised plugging of this well Cecil M. Jones

Producing formation Depth to top Bottom Total Depth of Well 3263 Feet

Show depth and thickness of all water, oil and gas formations.

OIL, GAS OR WATER RECORDS

CASING RECORD

FORMATION	CONTENT	FROM	TO	SIZE	PUT IN	PULLED OUT
				10 3/4	116	None
				6	None	2139

Describe in detail the manner in which the well was plugged, indicating where the mud fluid was placed and the method or methods used in introducing it into the hole. If cement or other plugs were used, state the character of same and depth placed, from feet to feet for each plug set.

Cleaned out cellar.

Working pipe. Sanded to 3200'. Dumped 5 sacks of cement. Shot pipe at 2120'.

Working pipe. Pulling pipe.

Pulling pipe. Plugging well at 150'. Build rock bridge.

Capped well with 5 yards of ready mix cement.

RECEIVED
STATE CORPORATION COMMISSION

MAY 28 1964

5-28-64
CONSERVATION DIVISION
Wichita, Kansas

(If additional description is necessary, use BACK of this sheet)

Name of Plugging Contractor Forbes Casing Pulling, Inc.

Address P. O. Box 221 Great Bend, Kansas

STATE OF Kansas, COUNTY OF Barton, ss.

J. C. Forbes (employee of owner) or (owner or operator) of the above-described well, being first duly sworn on oath, says: That I have knowledge of the facts, statements, and matters herein contained and the log of the above-described well as filed and that the same are true and correct. So help me God.

(Signature) J. C. Forbes

P. O. Box 221 Great Bend, Kansas

(Address)

SUBSCRIBED AND SWORN TO before me this 27 day of May, 19 64

My commission expires May 27, 1965

Notary Public.

DRILLERS LOGJ. C. Goering No. 11

Forbes

CASING RECORD:	COMPANY: Continental Oil Co.	DESCRIPTION:
10 3/4" @ 154' w/150 sacks cement	CONTRACTOR: L. W. Prunty Drilling Co.	W 1/2 Corner of Sec. 29-T21S-R1W, McPherson County, Kansas
6" OD @ 3243' w/300 sacks cement	COMMENCED: October 27, 1939	
	COMPLETED: November 22, 1939	
TOTAL DEPTH: 3300'		ELEVATION: 1473' GL

<u>FORMATION</u>	<u>FROM</u>	<u>TO</u>
Surface Clay	0	25
Sand	25	30
Shale and Shells	30	332
Shale	332	472
Shale and Shells	472	583
Broken Lime	583	803
Shale and Shells	803	1675
Broken Lime	1675	1919
Lime	1919	1994
Broken Lime	1994	2128
Shale and Shells	2128	2200
Lime	2200	2288
Broken Lime	2288	2300
Lime	2300	2679
Broken Lime	2679	2730
Shale and Shells	2730	2846
Shale	2846	2860
Shale and Shells	2860	2880
Shale	2880	2895
Chat	2895	3000
Lime	3000	3172
Shale and Lime Shells	3172	3188
Shale and Shells	3188	3241
Shale	3241	3254
Lime	3254	3300

Total Depth from ground level 3258'

RECEIVED
STATE CORPORATION COMMISSION

APR 7 1964

CONSERVATION DIVISION
Wichita, Kansas