

WELL PLUGGING RECORD

Give All Information Completely
Make Required Affidavit
Mail or Deliver Report to:
Conservation Division
State Corporation Commission
211 No. Broadway
Wichita, Kansas

McPherson County, Sec. 29 Twp. 21S Rge. 1 (E) (W) X

Location as "NE/CNW%SW%" or footage from lines 1320' F/S 1650' F/W

Lease Owner Forbes Casing Pulling, Inc.

Lease Name J. C. Goering Well No. 9

Office Address P. O. Box 221 Great Bend, Kansas

Character of Well (completed as Oil, Gas or Dry Hole)

Date well completed 19

Application for plugging filed 3-13-64 19

Application for plugging approved 3-17-64 19


Plugging commenced 4-28-64 19

Plugging completed 5-19-64 19

Reason for abandonment of well or producing formation Dry

If a producing well is abandoned, date of last production 19

Was permission obtained from the Conservation Division or its agents before plugging was commenced? Yes

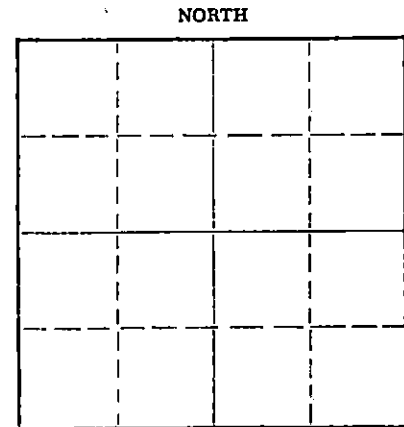

Locate well correctly on above Section Plat

Name of Conservation Agent who supervised plugging of this well Cecil M. Jones

Producing formation Depth to top Bottom Total Depth of Well 3287 Feet

Show depth and thickness of all water, oil and gas formations.

OIL, GAS OR WATER RECORDS

CASING RECORD

FORMATION	CONTENT	FROM	TO	SIZE	PUT IN	PULLED OUT
				10 3/4	7 1/2	None
				6	None	2131

Describe in detail the manner in which the well was plugged, indicating where the mud fluid was placed and the method or methods used in introducing it into the hole. If cement or other plugs were used, state the character of same and depth placed, from feet to feet for each plug set.

Cleaned out cellar.

Working pipe. Sanded to 3275'. Dumped 5 sacks of cement. Shot well at 2200' and 2120'.

Working pipe.

Working pipe. Pulling pipe.

Pulling pipe. Plugging well. Build rock bridge at 150'

Capped well with 5 yards of ready mix cement.

RECEIVED
STATE CORPORATION COMMISSION
MAY 26 1964
5-26-64
CONSERVATION DIVISION
Wichita, Kansas

(If additional description is necessary, use BACK of this sheet)

Name of Plugging Contractor Forbes Casing Pulling, Inc.

Address P. O. Box 221 Great Bend, Kansas

STATE OF Kansas, COUNTY OF Barton, ss.

J. C. Forbes (employee of owner) or (owner or operator) of the above-described

well, being first duly sworn on oath, says: That I have knowledge of the facts, statements, and matters herein contained and the log of the above-described well as filed and that the same are true and correct. So help me God.

(Signature)

P. O. Box 221 Great Bend, Kansas (Address)

SUBSCRIBED AND SWORN TO before me this 22 day of May, 1964

My commission expires May 27, 1965

Notary Public.

DRILLERS LOG

Fopbes

J. C. Goering No. 9

CASING RECORD:	COMPANY: Continental Oil Co.	DESCRIPTION:
10 3/4" @ 150' w/150 sacks cement	CONTRACTOR: Coffey Drilling Co.	SW 1/4 of Sec. 29-T21S- R1W, McPherson County, Kansas
6" OD @ 3262' w/300 sacks cement	COMMENCED: November 11, 1938	ELEVATION: 1465' DF
TOTAL DEPTH: 3303'	COMPLETED: December 5, 1938	

<u>FORMATION</u>	<u>FROM</u>	<u>TO</u>
Sand	0	20
Shale & Shells	20	145
Shale	145	149
Lime	149	152
Shale	152	170
Shale & Shells	170	499
Shale & Lime Shells	499	579
Broken Lime	579	693
Lime	693	768
Broken Lime	768	871
Shale	871	1127
Shale & Shells	1127	1619
Broken Lime	1619	1814
Lime	1814	1860
Shale	1860	1899
Shale & Shells	1899	1930
Lime	1930	1953
Lime	1953	2010
Broken Lime	2010	2075
Shale & Shells	2075	2106
Sandy Shale	2106	2255
Broken Lime	2255	2322
Lime	2322	2713
Broken Lime	2713	2755
Shale & Shells	2755	2843
Broken Lime	2843	2885
Shale	2885	2905
Chat	2905	3000
Lime	3000	3186
Dolomite	3186	3205
Lime	3205	3225
Shale	3225	3259
Hunton Lime	3259	3301
Shale	3301	3303

RECEIVED
STATE CORPORATION COMMISSION

APR 7 1964

CONSERVATION DIVISION
Wichita, Kansas