


Give All Information Completely
Make Required Affidavit
Mail or Deliver Report to:
Conservation Division
State Corporation Commission
211 No. Broadway
Wichita, Kansas

WELL PLUGGING RECORD

McPherson County, Sec. 29 Twp. 21 Rge. 1W (E) (W)

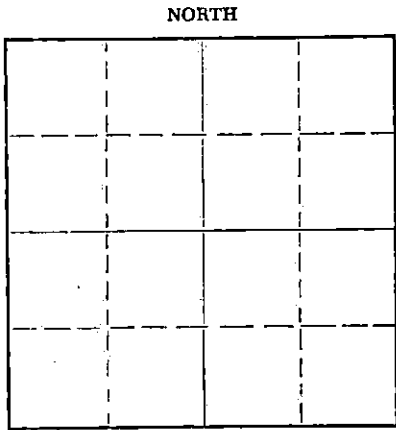

Locate well correctly on above Section Flat

Location as "NE/CNW/SW" or footage from lines C W/2E/2
Lease Owner Jenkins-Ray Supply
Lease Name Huxman Well No. 7
Office Address _____
Character of Well (completed as Oil, Gas or Dry Hole) Oil
Date well completed 3-5-38 19____
Application for plugging filed 7-20-65 19____
Application for plugging approved 7-23-65 19____
Plugging commenced 7-30-65 19____
Plugging completed 8-3-65 19____
Reason for abandonment of well or producing formation Depleted

If a producing well is abandoned, date of last production Not known 19____
Was permission obtained from the Conservation Division or its agents before plugging was commenced? Yes

Name of Conservation Agent who supervised plugging of this well Gilbert Toman
Producing formation _____ Depth to top _____ Bottom _____ Total Depth of Well 3292 Feet
Show depth and thickness of all water, oil and gas formations.

OIL, GAS OR WATER RECORDS

CASING RECORD

FORMATION	CONTENT	FROM	TO	SIZE	PUT IN	PULLED OUT
				10"	142	None
				7"OD	3292	2427'

Describe in detail the manner in which the well was plugged, indicating where the mud fluid was placed and the method or methods used in introducing it into the hole. If cement or other plugs were used, state the character of same and depth placed, from _____ feet to _____ feet for each plug set.

Checked hole to 3292' sanded hole to 2420' dumped gravel to 2403' and dumped 6 sacks cement- set gridge at 170' poured gravel and dumped 2 sacks cement- and dumped 4 yads Redi mix cement to base of top collar

RECEIVED
STATE CORPORATION COMMISSION

DEC 29 1965
12-29-65
CONSERVATION DIVISION
Wichita, Kansas

(If additional description is necessary, use BACK of this sheet)

Name of Plugging Contractor Albert Leach
Address Sterling Colorado

STATE OF Oklahoma COUNTY OF Kay ss.
C.C. Jenkins (employee of owner) or (owner or operator) of the above-described well, being first duly sworn on oath, says: That I have knowledge of the facts, statements, and matters herein contained and the log of the above-described well as filed and that the same are true and correct. So help me God.


(Signature) C.C. Jenkins
Box 967, Ponca City, Oklahoma
(Address)

SUBSCRIBED AND SWORN TO before me this 27 day of Dec 1965
Marnie Barber
Notary Public.

My commission expires 8-3-67

15.113.04609.0000

WELL RECORD

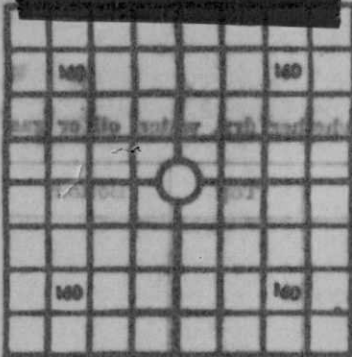

Locate Well Correctly

MAIL TO CORPORATION COMMISSION, OKLAHOMA CITY, OKLAHOMA
 COUNTY McPherson SEC 29 TWP 21S RGE W
 COMPANY OPERATING Continental Oil Company
 OFFICE ADDRESS Forse City, Oklahoma
 FARM NAME J. P. Huxman WELL NO. 77
 DRILLING STARTED February 10, 1938 DRILLING FINISHED Mar. 5, 1938
 DATE OF FIRST PRODUCTION 3-8-1938 COMPLETED
 WELL LOCATED 1320' South and 990' West of North 1/4
Corner of above section East of West Line of Quarter Section.
 Elevation (Relative to sea level) DERRICK FLOOR _____ GROUND _____
 CHARACTER OF WELL (Oil, gas or dry hole) Oil

OIL OR GAS SANDS OR ZONES

Name	From	To	Name	From	To
1 Hunton Lime	3268	3290	4		
2			5		
3			6		

WATER SANDS

Name	From	To	Water level	Name	From	To	Water level
1				4			
2				5			
3				6			

CASING RECORD

Size	Wt.	Thds.	Make	Amount Set		Amount Pulled		Packer Record			
				Ft.	In.	Ft.	In.	Size	Length	Depth Set	Make
10"				142	8						
7"OD	20#	10		3292	1						

Liner Record: Amount _____ Kind _____ Top _____ Bottom _____

CEMENTING AND MUDDING RECORD

Size	Amount Set		Sacks Cement	Chemical		Method of Cementing	Amount	Mudding Method	Results (See Note)
	Ft.	In.		Gal.	Make				
10"	142	8	150			Halliburton			
7"OD	3292	1	300			"			

NOTE: What method was used to protect sands when outer strings were pulled? _____

NOTE: Were bottom hole plugs used? _____ If so, state kind, depth set and results obtained _____

TOOLS USED

Rotary tools were used from 0 feet to 3270 feet, and from _____ feet to _____ feet
 Cable tools were used from 3270 feet to 3291 feet, and from _____ feet to _____ feet

Type Rig _____

PRODUCTION DATA

Production first 24 hours 452 bbls. Gravity _____, Emulsion _____ per cent., Water _____ per cent
 Production second 24 hours _____ bbls. Gravity _____, Emulsion _____ per cent., Water _____ per cent
 If gas well, cubic per 24 hours _____ Rock Pressure; lbs. per square inch _____

I, the undersigned, being first duly sworn upon oath, state that this well record is true, correct and complete according to the records of this office and to the best of my knowledge and belief.

Name and title of representative of company. _____

Subscribed and sworn to before me this 21 day of March, 1938

My Commission expires _____

Notary Public.


FORMATION RECORD

Give detailed description and thickness of all formations drilled through and contents of sand, whether dry, water, oil or gas

Formation	Top	Bottom	Formation	Top	Bottom
Surface Clay & Sand	0	25			
Shale	25	44			
Shale & Shells	44	85			
Sand	85	90			
Shale & Shells	90	134			
Broken Lime	134	148			
Lime	148	153	Set 142' 8" of 10" Csg.		
Shale	153	219	* 149' and cemented w/		
Shale & Shells	219	736	150 sacks Lone Star Cement		
Shale	736	754			
Lime	754	832			
Shale & Shells	832	1337			
Shale	1337	1387			
Broken Lime	1387	1477			
Shale & Shells	1477	1638			
Shale	1638	1797			
Broken Lime	1797	1853			
Shale & Shells	1853	1945			
Broken Lime	1945	2105			
Shale	2105	2123			
Shale & Shells	2123	2257			
Broken Lime	2257	2310			
Lime	2310	2681			
Shale	2681	2735			
Shale & Shells	2735	2847			
Shale	2847	2900			
Chat	2900	3040			
Lime	3040	3185			
Shale	3185	3269			
Hunton Lime	3269	3290	Set 3292' 1" of 7" OD Csg.		
Shale	3290	3291	* 3269' and cemented with		
			300 sacks Ash Grove Cement		
			900' oil in hole from 3271' to 3276'		
			in one hour		
			500' oil in hole from 3276' to 3290'.		

RECEIVED STATE CORPORATION COMMISSION

JUL 23 1965

CONSERVATION DIVISION Wichita, Kansas