


WELL PLUGGING RECORD

Give All Information Completely  
Make Required Affidavit  
Mail or Deliver Report to:  
Conservation Division  
State Corporation Commission  
212 No. Market  
Wichita, Kansas

NORTH

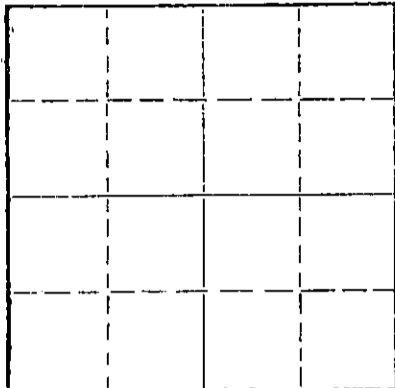

Locate well correctly on above  
Section Plat

Rush County, Sec. 9 Twp. 19 Rge. 20 (E) W (W)

Location as "NE/CNW/SW" or footage from lines NW/4 SW/4  
Shields Oil Producers, Inc.

Lease Owner Shields Oil Producers, Inc.

Lease Name Young "B" Well No. 1

Office Address Shields Building, Russell, Kansas

Character of Well (completed as Oil, Gas or Dry Hole) Dry hole

Date well completed August 4, 19 69

Application for plugging filed August 4, 19 69

Application for plugging approved August 4, 19 69

Plugging commenced August 4, 19 69

Plugging completed August 4, 19 69

Reason for abandonment of well or producing formation Dry hole

If a producing well is abandoned, date of last production 19

Was permission obtained from the Conservation Division or its agents before plugging was commenced? Yes

Name of Conservation Agent who supervised plugging of this well Leo Massey

Producing formation Depth to top Bottom Total Depth of Well 4,400 Feet

Show depth and thickness of all water, oil and gas formations.

OIL, GAS OR WATER RECORDS

CASING RECORD

FORMATION	CONTENT	FROM	TO	SIZE	PUT IN	PULLED OUT
				8 5/8"	245'	Cmtd. w/185 sax

Describe in detail the manner in which the well was plugged, indicating where the mud fluid was placed and the method or methods used in introducing it into the hole. If cement or other plugs were used, state the character of same and depth placed, from feet to feet for each plug set.

Fill hole w/ heavy mud  
Set bridge plug @ 600'  
Pump 70 sax cement on plug thru 4 1/2" drill pipe  
Set bridge plug @ 240'  
Pump 20 sax cement on plug thru 4 1/2" drill pipe  
Fill hole w/ heavy mud  
Set bridge plug @ 40' w/ 1/2 sax hulls on plug  
Dump 10 sax cement on plug to cellar

RECEIVED  
STATE CORPORATION COMMISSION  
SEP 17 1969  
CONSERVATION DIVISION  
Wichita, Kansas

9-17-69

(If additional description is necessary, use BACK of this sheet)

Name of Plugging Contractor Shields Drilling Co., Inc.

Address Shields Building, Russell, Kansas

STATE OF Kansas, COUNTY OF Russell, ss.  
R. J. Shields (employee of owner) or (owner or operator) of the above-described well, being first duly sworn on oath, says: That I have knowledge of the facts, statements, and matters herein contained and the log of the above-described well as filed and that the same are true and correct. So help me God.

(Signature) R. J. Shields  
Shields Building, Russell, Kansas  
(Address)

SUBSCRIBED AND SWORN TO before me this 10th day of September, 1969

Rush Phillips  
Notary Public.

My commission expires May 26, 1971



# Shields


## WELL LOG

Russell, Kansas

15.165.20246.00.00

Operator: Shields Oil Producers, Inc.  
 Well: Young "B" #1  
 Commenced: July 27, 1969  
 Completed: August 4, 1969  
 Contractor: Shields Drilling Co., Inc.

Well Description: NW/4 SW/4  
 Sec. 9-19S-20W  
 Rush County, Kansas

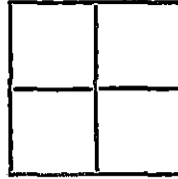

**CASING RECORD**

Size	Run	Pulled
8 5/8"	245'	Cmtd. w/ 185 sax

Elevation: 2,261' RB

Treatment:

Production: D & A

Tops:

Heebner	3,768'
Toronto	3,789'
Lansing-KC	3,814'
Ft. Scott	4,283'
Cherokee Sand	4,290'
Mississippi	4,388'

..... Figures Indicate Bottom of Formations .....

Clay, shale & sand	250'
Shale & shells	750'
Shale & sand	1,250'
Redbed	1,493'
Anhydrite	1,526'
Shale & shells	1,990'
Shale & lime	2,365'
Lime	2,810'
Lime & shale	3,600'
Lime	3,645'
Lime & shale	4,015'
Lime	4,400' RTD

RECEIVED  
 STATE CORPORATION COMMISSION  
 SEP 17 1969  
 CONSERVATION DIVISION  
 Wichita, Kansas

### NOTES

DST #1 4,285' - 4,295'

Tool open w/ weak blow for 5 min.  
 Recovered 3' mud. No pressure taken.