


Give All Information Completely
Make Required Affidavit
Mail or Deliver Report to:
Conservation Division
State Corporation Commission
211 No. Broadway
Wichita, Kansas

WELL PLUGGING RECORD

Rush County. Sec. 9 Twp. 19 Rge. 20 (E) W (W)
Location as "NE/CNW/SW" or footage from lines SE SE SE
Lease Owner Shields Oil Producers Inc.
Lease Name Young C. Well No. 2
Office Address Shields Bldg. Russell, Kansas
Character of Well (completed as Oil, Gas or Dry Hole) Oil well
Date well completed August 3 1961
Application for plugging filed February 15 1965
Application for plugging approved February 17 1965
Plugging commenced Feb. 25 1965
Plugging completed March 9 1965
Reason for abandonment of well or producing formation Depleted well

NORTH

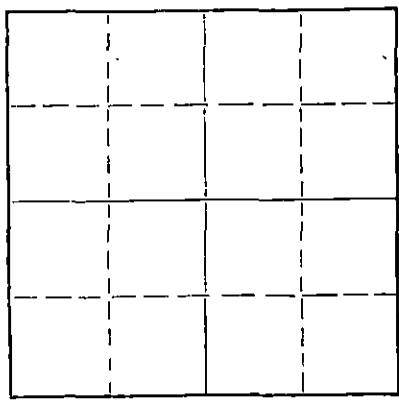

Locate well correctly on above Section Flat

If a producing well is abandoned, date of last production January 1965
Was permission obtained from the Conservation Division or its agents before plugging was commenced? Yes

Name of Conservation Agent who supervised plugging of this well Petty
Producing formation _____ Depth to top _____ Bottom _____ Total Depth of Well 4284 Feet
Show depth and thickness of all water, oil and gas formations.

OIL, GAS OR WATER RECORDS

CASING RECORD

FORMATION	CONTENT	FROM	TO	SIZE	PUT IN	PULLED OUT
				8 5/8"	215'	Contd w/ 125' sup
				5 1/2"	4319'	3087'

Describe in detail the manner in which the well was plugged, indicating where the mud fluid was placed and the method or methods used in introducing it into the hole. If cement or other plugs were used, state the character of same and depth placed, from 4284 feet to surface feet for each plug set.

Sanded up to 4200' dump 4 sacks of cement on bottom. Pulled pipe from bottom to 550' circ. mud & pump 20 sacks of cement to 550'. Pulled pipe to 200' pump 20 sacks of cement to 200', pulled pipe out put 10 sacks on top. Well completed.

4-26-65

RECEIVED
STATE CORPORATION COMMISSION
APR 26 1965
CONSERVATION DIVISION
Wichita, Kansas

(If additional description is necessary, use BACK of this sheet)

Name of Plugging Contractor Barnes & Sons Pipe Pulling Co.
Address P.O. Box 313 Russell, Kansas

STATE OF Kansas, COUNTY OF Russell, ss.
Jack P. Beerman (employee of owner) or (~~owner or operator~~) of the above-described well, being first duly sworn on oath, says: That I have knowledge of the facts, statements, and matters herein contained and the log of the above-described well as filed and that the same are true and correct. So help me God.

(Signature) Jack P. Beerman
Shields Bldg, Russell, Kansas (Address)

SUBSCRIBED AND SWORN TO before me this 23rd day of April, 1965

Selma Underwood
Notary Public.

My commission expires September 27, 1967



Shields


15. 02000. 00. 00

Russell, Kansas

WELL LOG

Operator: Shields Oil Producers, Inc.
 Well: Ada Young "C" #2
 Commenced: July 24, 1961
 Completed: August 3, 1961
 Contractor: Shields Drilling Co., Inc.

Well Description SE SE SE
 Sec. 9-19S-20W
 Rush County, Kansas

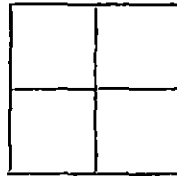

CASING RECORD		
Size	Run	Pulled
8 5/8"	215'	Cmtd. w/ 125 sax
5 1/2"	4,319'	Cmtd. w/ 75 sax

Elevation: 2,216' RB
 Treatment:
 Production:
 Tops: Heebner 3,704'
 Lansing-KC 3,747'
 Ft. Scott 4,212'
 Cherokee Sd. 4,221'
 Mississippi Lm. 4,296'

..... Figures Indicate Bottom of Formations

Surface soil & flint stones	215'
Shale, shells & sand	800'
Redbed & sand	1,433'
Anhydrite	1,468'
Shale & shells	1,890'
Shale & lime	2,480'
Lime	2,700'
Lime & shale	2,915'
Lime	3,035'
Lime & shale	3,400'
Lime	4,215'
Sand & Lime	4,245'
Sand, lime & shale	4,300'
Lime & chat	4,320' RTD

2216
 1468

 748

RECEIVED
 STATE CORPORATION COMMISSION
 FEB 17 1965
 CONSERVATION DIVISION
 Wichita, Kansas

Notes

DST #1 4,216'-4,225'

Tool open 1 hr. w/ strong blow diminishing to weak. Recovered 2,490' oil, 60' HOCM, 434' water. IFP-613#, FFP-1,091#, FBHP-1,102#/ 20 min.