


STATE OF KANSAS RECEIVED
STATE CORPORATION COMMISSION STATE CORPORATION COMMISSION

Give All Information Completely OCT 26 1976
Make Required Affidavit
Mail or Deliver Report to
Conservation Division
State Corporation Commission
245 North Water
Wichita, KS 67202

CONSERVATION DIVISION
Wichita, Kansas

FORM CP-4

WELL PLUGGING RECORD

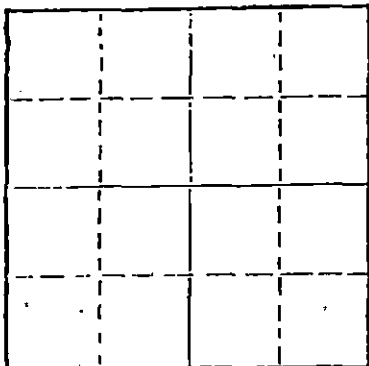

Locate well correctly on above Section Plat

Rush County. Sec. 9 Twp. 19S Rge. 20 (E) W (W)
Location as "NE/CNW/SW" or footage from lines 150 N-CW/2 NE/4
Lease Owner Phillips Petroleum Company
Lease Name Bellport "AB" Well No. 2
Office Address Box 287, Great Bend, Kansas 67530
Character of Well (completed as Oil, Gas or Dry Hole) Dry hole
Date well completed 10-20-76 19
Application for plugging filed 10-20-76 19
Application for plugging approved 10-20-76 19
Plugging commenced 10-20-76 19
Plugging completed 10-20-76 19
Reason for abandonment of well or producing formation Dry hole
If a producing well is abandoned, date of last production 19
Was permission obtained from the Conservation Division or its agents before plugging was commenced? Yes

Name of Conservation Agent who supervised plugging of this well Leo F. Massey
Producing formation _____ Depth to top _____ Bottom _____ Total Depth of Well 4241' Feet
Show depth and thickness of all water, oil and gas formations.

OIL, GAS OR WATER RECORDS

CASING RECORD

FORMATION	CONTENT	FROM	TO	SIZE	PUT IN	PULLED OUT
	Surface	0	474'	8 5/8"	Yes	No

Describe in detail the manner in which the well was plugged, indicating where the mud fluid was placed and the method or methods used in introducing it into the hole. If cement or other plugs were used, state the character of same and depth placed, from _____ feet to _____ feet for each plug set.
Bottom Plug - 4241'-4145' with 35 sacks
2nd Plug - 554'-350' with 65 sacks
3rd Plug - 245'-175' with 25 sacks
Bridge @ 40' with 10 sacks
2 sacks in rathole
Job completed at 11:30 P.M. - 10-20-76

(If additional description is necessary, use BACK of this sheet)
Name of Plugging Contractor Slawson Drilling Company, Inc.
Address 408 One Twenty Building, Wichita, Kansas 67202

STATE OF Kansas COUNTY OF Barton ss.
C. D. Dohrer (employee of owner) or (owner or operator) of the above-described

well, being first duly sworn on oath, says: That I have knowledge of the facts, statements, and matters herein contained and the log of the above-described well as filed and that the same are true and correct. So help me God.

(Signature) C. D. Dohrer
Box 287, Great Bend, Kansas 67530
(Address)

Subscribed and Sworn to before me this 21st day of October 1976

My commission expires _____ Notary Public.

