


Give All Information Completely  
Make Required Affidavit  
Mail or Deliver Report to:  
Conservation Division  
State Corporation Commission  
211 No. Broadway  
Wichita, Kansas

WELL PLUGGING RECORD

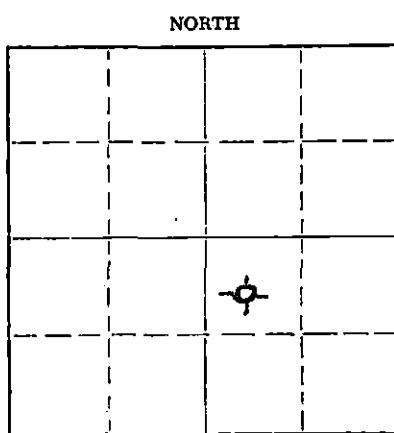

Locate well correctly on above  
Section Plat

Rush County. Sec. 30 Twp. 19S Rge. 19W (E) (W)  
Location as "NE/CNW%SW%" or footage from lines C NW/4 SE/4  
Lease Owner Icer Addis  
Lease Name Young Well No. 1  
Office Address P. O. Box 519, Great Bend, Kansas  
Character of Well (completed as Oil, Gas or Dry Hole) Dry Hole  
Date well completed March 23rd 19 63  
Application for plugging filed March 23rd 19 63  
Application for plugging approved March 23rd 19 63  
Plugging commenced March 23rd 19 63  
Plugging completed March 23rd 19 63  
Reason for abandonment of well or producing formation \_\_\_\_\_

If a producing well is abandoned, date of last production \_\_\_\_\_ 19 \_\_\_\_  
Was permission obtained from the Conservation Division or its agents before plugging was commenced? Yes

Name of Conservation Agent who supervised plugging of this well Eldon Petty, Hays, Kansas  
Producing formation Fort Scott Depth to top \_\_\_\_\_ Bottom \_\_\_\_\_ Total Depth of Well 4274 Feet  
Show depth and thickness of all water, oil and gas formations.

OIL, GAS OR WATER RECORDS

CASING RECORD

FORMATION	CONTENT	FROM	TO	SIZE	PUT IN	PULLED OUT
				8-5/8"	386'	-0-

Describe in detail the manner in which the well was plugged, indicating where the mud fluid was placed and the method or methods used in introducing it into the hole. If cement or other plugs were used, state the character of same and depth placed, from \_\_\_\_\_ feet to \_\_\_\_\_ feet for each plug set.

Set bottom plug @ 480' with 20 sacks cement through drill pipe.  
Set second plug @ 350' with 20 sacks cement through drill pipe.  
Set top plug @ 40' with 10 sacks cement. Job complete @ 2:00 p.m.

RECEIVED  
STATE CORPORATION COMMISSION

APR 17 1963

CONSERVATION DIVISION  
Wichita, Kansas

4-17-63

(If additional description is necessary, use BACK of this sheet)  
Name of Plugging Contractor Walters Drilling Co.  
Address 510 Orpheum Building, Wichita, Kansas

STATE OF KANSAS, COUNTY OF SEDGWICK, ss.  
ROBERT F. WALTERS (employer or operator) or (owner or operator) of the above-described well, being first duly sworn on oath, says: That I have knowledge of the facts, statements, and matters herein contained and the log of the above-described well as filed and that the same are true and correct. So help me God.  
(Signature) Robert F. Walters  
ROBERT F. WALTERS, Partner  
510 Orpheum Building, Wichita, Kansas  
(Address)

SUBSCRIBED AND SWORN to before me this 25th day of March, 1963

My commission expires January 11th, 1967.  
Velma L. Deines  
Notary Public.

YOUNG #1

LOCATION: C NW/4 SE/4 Section 30-19S-19W DATE SPUDDED: 3-15-63  
 Rush County, Kansas  
 OPERATOR: Icer Addis ROTARY COMPLETION: 3-23-63  
 CONTRACTOR: Walters Drilling Co. ELEVATION: 2280 KB  
 SURFACE CASING: 8-5/8" @ 386' w/200 sa cks cement  
 OIL STRING: None

L O G

(Figures indicate bottom of formation)

Shale & Shells	0-859'
Sand & Shale	1080'
Shale & Shells	1444'
Anhydrite	1476'
Shale & Shells	2165'
Lime & Shale	3830'
Lime	4115'
Lime & Shale	4245'
Shale & Sand	4265'
Sand, Shale & Lime	4274'
Total Depth	4274'


The undersigned, Robert F. Walters, hereby certifies that the above log is a true and correct log of the formations encountered in drilling the above noted well as reflected by the Daily Drilling Reports.

WALTERS DRILLING CO.

By

  
 ROBERT F. WALTERS, Partner

Subscribed and sworn to before me  
 this 12th day of April, 1963.

  
 Velma L. Deines, Notary Public

My commission expires January 11th, 1967.

 RECEIVED  
 STATE CORPORATION COMMISSION

APR 17 1963

 CONSERVATION DIVISION  
 Wichita, Kansas