


STATE OF KANSAS  
STATE CORPORATION COMMISSION  
200 Colorado Derby Bldg.  
Wichita, Kansas 67202

Form CP-4  
Rev. 12-15-80

WELL PLUGGING RECORD

Give All Information Completely.  
Make Required Affidavit

COUNTY RUSH SEC. 34 TWP. 19 RGE. 16 =E/W  
Location as in quarters or footage from lines:  
C-SW 1320' E.S.L.

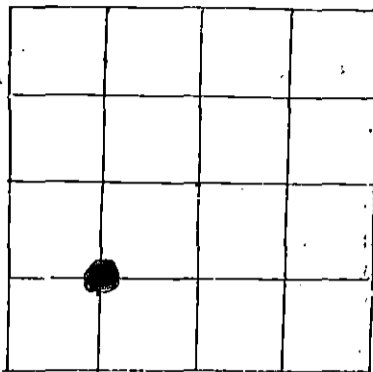

Locate Well  
correctly on above  
Section Platt.

Lease Owner Eagle Explorations, Inc.  
Lease Name Eagle Hagerman Well No. 1  
Office Address Suite 300, 107 N. Market Wichita, Kansas 67202  
Character of Well (Completed as Oil, Gas or Dry Hole): Dry Hole  
Date Well Completed 1981-07-16  
Application for plugging filed \_\_\_\_\_  
Plugging commenced 1981-07-16 5:00 P.M.  
Plugging completed 1981-07-16 8:30 P.M.  
Reason for abandonment of well or producing formation \_\_\_\_\_

NO SHOWS

Was permission obtained from the Conservation Division or it's  
Agent's before plugging was commenced? YES

Name of Conservation Agent who supervised plugging of this well Marion Schmidt

Producing formation None Depth to top \_\_\_\_\_ bottom T.D.

Show depth and thickness of all water, oil and gas formations.

OIL, GAS OR WATER RECORDS

Casing Record

Formation	Content	From	To	Size	Put in	Pulled Out


Describe in detail the manner in which the well was plugged, indicating where the mud fluid was placed and the method or methods used in introducing it into the hold. If cement or other plugs were used, state the character of same and depth placed, from \_\_\_\_\_ feet to \_\_\_\_\_ feet for each plug set.

Well circulated with 9.4#/gal., 48 Sec/qt. Viscosity Mud.

The following plugs were placed through drill pipe.

- 1. Plug #1 1,120' - 965' 55 Sacs 1:1 Pozmix + 3% CaCl<sub>2</sub> + 4% Gel
- 2. Plug #2 270' - 160' 40 Sacs 1:1 Pozmix + 3% CaCl<sub>2</sub> + 4% Gel
- 3. Plug #3 40' - 10' 10 Sacs 1:1 Pozmix + 3% CaCl<sub>2</sub> + 4% Gel

Placed 8 5/8" Wider Plug On Top Of Plug #3

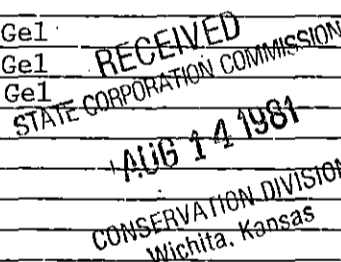

(If additional description is necessary, use BACK of this sheet)

Name of Plugging Contractor SARCEE DRILLING

STATE OF KANSAS COUNTY OF SEDGWICK, ss.

D.R. Ramsay (employee of owner) or (owner or operator) of the above-described well, being first duly sworn on oath, says: That I have knowledge of the facts, statements, and matters herein contained and the log of the above-described well as filed and that the same are true and correct. So help me God.

(Signature) D. R. Ramsay  
(Address) \_\_\_\_\_

SUBSCRIBED AND SWORN TO before me this 13th day of August, 19 81

Sharon I. Clark  
SHARON I. CLARK Notary Public.

My Commission expires: March 16, 1983

