


STATE OF KANSAS
STATE CORPORATION COMMISSION

Give All Information Completely
Make Required Affidavit
Mail or Deliver Report to:
Conservation Division
State Corporation Commission
800 Bittig Building
Wichita, Kansas

WELL PLUGGING RECORD

Rush County. Sec. 26 Twp. 19S Rge. 16 (W)
Location as "NE/CNW/SW" or footage from lines SW SW SW
Lease Owner Champlin Oil & Refining Co.
Lease Name McKinney Well No. 2
Office Address 306 Koch Building, Wichita, Kansas
Character of Well (completed as Oil, Gas or Dry Hole) Oil
Date well completed May 26, 1948
Application for plugging filed November 1, 1957
Application for plugging approved November 4, 1957
Plugging commenced November 13, 1957
Plugging completed November 15, 1957
Reason for abandonment of well or producing formation
Non Commerical Production
If a producing well is abandoned, date of last production November 2, 1957
Was permission obtained from the Conservation Division or its agents before plugging was commenced? Yes

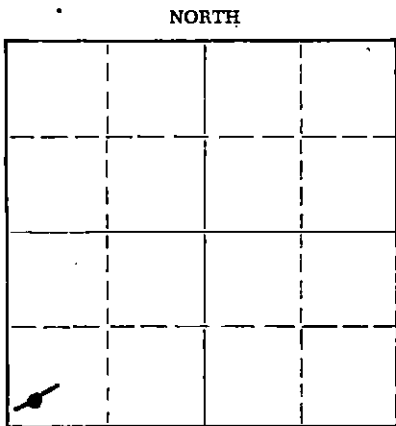

Locate well correctly on above Section Plat

Name of Conservation Agent who supervised plugging of this well Don Truan
Producing formation Arbuckle Depth to top _____ Bottom _____ Total Depth of Well 3689 Feet PBTD
Show depth and thickness of all water, oil and gas formations.

OIL, GAS OR WATER RECORDS

CASING RECORD

FORMATION	CONTENT	FROM	TO	SIZE	PUT IN	PULLED OUT
				8 5/8" OD	1040'	None
				4 1/2" OD	3731'	2035'

Describe in detail the manner in which the well was plugged, indicating where the mud fluid was placed and the method or methods used in introducing it into the hole. If cement or other plugs were used, state the character of same and depth placed, from _____ feet to _____ feet for each plug set.

Plugged back from 3689' PBTD with crushed rock to 3665'. Dumped 5 sx cement with dump bailer, filling hole to 3610'. Pumped in 20 sx Gel Mud and 100 sx cement in 8 5/8" casing, filling hole to bottom of cellar.

Used Halliburton to plug well.

(If additional description is necessary, use BACK of this sheet)
Name of Plugging Contractor Miller Casing Pulling Co. (Plugging License #12)
Address Box 711, Great Bend, Kansas

STATE OF Kansas, COUNTY OF Sedgwick, ss.
J. W. Meyers (employee of owner) ~~owner or operator~~ of the above-described well, being first duly sworn on oath, says: That I have knowledge of the facts, statements, and matters herein contained and the log of the above-described well as filed and that the same are true and correct. So help me God.

(Signature) J. W. Meyers
306 Koch Building, Wichita, Kansas (Address)

SUBSCRIBED AND SWORN TO before me this 26th day of November, 1957.

My commission expires February 22, 1961 Notary Public.

NOV 27 1957
CONSERVATION DIVISION
Wichita, Kansas
11-27-57

PLUGGING
FILE SEC. 26 T. 19 R. 16W
BOOK PAGE 58 LINE 36

TO KANSAS CORPORATION COMMISSION
 Conservation Division
 800 Bitting Building
 Wichita, Kansas

County Rush SEC. 26 TWP 19S RGE. 16W

COMPANY OPERATING Champlin Oil & Refining Co.

OFFICE ADDRESS 306 Koch Building, Wichita, Kansas

FARM NAME McKinney WELL NO. 2

WELL LOCATED SW SW SW

CHARACTER OF WELL Oil

DRILLING COMMENCED _____ DRILLING COMPLETED _____

SIZE	WEIGHT	THDS	MAKE	FT.	AMOUNT PULLED	CEMENT
8 5/8"OD	22.7	SJ	Spiral-Weld	1040'	None	450 sx

FORMATION RECORD

TOPS	BOTTOM		TOPS	BOTTOM
0	- 40	SURFACE CLAY & SAND		
40	- 595	SHALE & SHELLS		
595	- 855	RED BED & SHALE		
855	-1042	RED BED & SHELLS		
1042	-1080	ANHYDRITE		
1080	-1345	SHALE & SHELLS		
1345	-1615	SHALE, SALT & SHELLS		
1615	-1790	SHALE & SHELLS		
1790	-2395	LIME & SHALE		
2395	-2535	SHALE		
2535	-2710	SHALE & LIME		
2710	-2805	SHALE & SHELLS		
2805	-2865	LIME		
2865	-3110	LIME & SHALE		
3110	-3295	LIME		
3295	-3531	LIME & SHALE		
3531	-3730	LIME		
3730	-3736	LIME & SHALE		
3736	-3741	LIME		
3689		PBTD		

PLUGGING
 FILE SEC. 26 T. 19 R. 16W
 BOOK PAGE 58 LINE 36

RECEIVED
 CONSERVATION DIVISION

NOV 6 1957

CONSERVATION DIVISION

J. W. Meyers
 Superintendent
M. Kenneth Starns
 Notary Public

Subscribed and sworn to before me
 this 5th day of November, 1957
 My commission expires February 22, 1961