

STATE OF KANSAS
STATE CORPORATION COMMISSION


Give All Information Completely
Make Required Affidavit
Mail or Deliver Report to:
Conservation Division
State Corporation Commission
211 No. Broadway
Wichita, Kansas

WELL PLUGGING RECORD

Rush County. Sec. 26 Twp. 19 Rge. (E) 16 (W)

Location as "NE/CNW%SW%" or footage from lines SW SW SE
Lease Owner A. H. Kasishke, D/B/A Alkay Oil Company
Lease Name Conrad Tammen Well No. 1
Office Address 611 Kennedy Building, Tulsa, Oklahoma
Character of Well (completed as Oil, Gas or Dry Hole) oil
Date well completed February 1 19 50
Application for plugging filed July 16 19 56
Application for plugging approved July 17 19 56
Plugging commenced July 21 19 56
Plugging completed July 26 19 56
Reason for abandonment of well or producing formation no longer commercial producer

NORTH

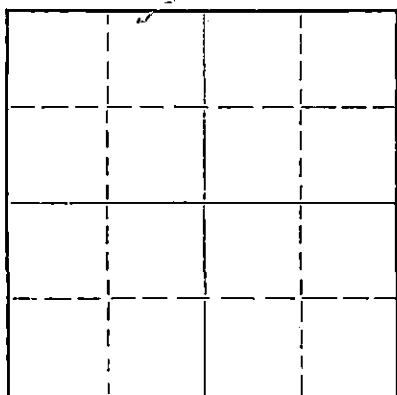

Locate well correctly on above
Section Plat

If a producing well is abandoned, date of last production June 15 19 56
Was permission obtained from the Conservation Division or its agents before plugging was commenced? yes

Name of Conservation Agent who supervised plugging of this well Russell Brundage
Producing formation _____ Depth to top _____ Bottom _____ Total Depth of Well 3741 Feet
Show depth and thickness of all water, oil and gas formations.

OIL, GAS OR WATER RECORDS

CASING RECORD

FORMATION	CONTENT	FROM	TO	SIZE	PUT IN	PULLED OUT
				8 5/8	1050'	---
				5 1/2	3730'	2842'

Describe in detail the manner in which the well was plugged, indicating where the mud fluid was placed and the method or methods used in introducing it into the hole. If cement or other plugs were used, state the character of same and depth placed, from _____ feet to _____ feet for each plug set.

Mudded to 300' set 5' rock bridge and dumped 30 sx cement. Mudded 59 35' set 5' rock bridge and dumped 10 sx cement to base of cellar.

(If additional description is necessary, use BACK of this sheet)

Name of Plugging Contractor Ace Pipe Pulling Company
Address P. O. Box 304, Great Bend, Kansas

STATE OF OKLAHOMA, COUNTY OF TULSA, ss.
E. G. Moehlenkamp (employee of owner) or (owner or operator) of the above-described

well, being first duly sworn on oath, says: That I have knowledge of the facts, statements, and matters herein contained and the log of the above-described well as filed and that the same are true and correct. So help me God.

(Signature) *E. G. Moehlenkamp*
611 Kennedy Building, Tulsa, Oklahoma
(Address)

SUBSCRIBED AND SWORN TO before me this 7th day of August, 19 56

My commission expires March 28, 1957

Luene Stark
Notary Public.

RECEIVED
STATE CORPORATION COMMISSION

PLUGGING
FILE SEC 26 T. 19 R. 16W
BOOK PAGE 80 LINE 45

AUG 8 1956
CONSERVATION DIVISION

8-8-56

WELL LOG

ALKAY OIL COMPANY
929 Kennedy Bldg.
Tulsa, Okla.

Conrod T. Temmen
SW SW SE 26-19S-16W
Rush County, Kansas

Elevation - Derrick Floor 1996

Commenced - 1-9-50
Completed - 2-1-50

Casing Record:

8 5/8" - 1050' - 500 Sacks Cement
5 1/2" - 3730' - 125 Sacks Cement

I.P. 35 Barrels
Acid - 1000 gallon

<u>FROM</u>	<u>TO</u>	<u>REMARKS</u>
0	155	Clay & Shale
155	400	Shale & Shells
400	620	Sand & Shale
620	740	Sand & Shale
740	960	Shale & Red Rock
960	1038	Red Rock
1038	1050	Anhydrite
1050	1068	"
1068	1290	Red Bed - Shale & Shells
1290	1365	Red Bed & Shale
1365	1595	Shale & Shells
1595	1775	Shale & Shells
1775	1840	Lime & Shale
1840	2005	Lime & Shale
2005	2165	Lime
2165	2730	Lime & Shale
2730	2855	Shale
2855	2950	Shale & Shells
2950	3025	Shale & Shells
3025	3105	Lime
3105	3175	Lime & Shale
3175	3222	Lime
3222	3232	Shale
3232	3325	Lime
3325	3400	Broken Lime
3400	3427	Lime & Shale
	3427	Kansas City
3427	3472	Lime
3472	3536	Broken Lime
3536	3675	Lime
	3675	Arbuckle
3675	3732	Lime
	3732	Total Depth - Rotary

Cable Tools

3732 3741 Lime

PLUGGING
FILE SEC 26 T 19 R 160
BOOK PAGE 80 LINE 45

RECEIVED
JUL 1 1950
WELL LOGS