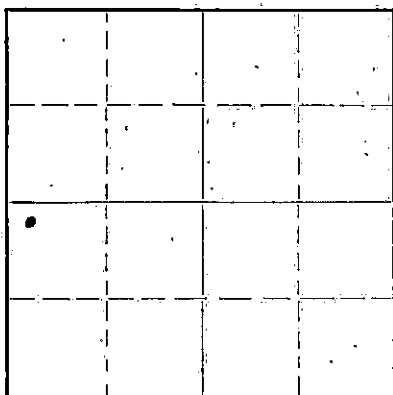


STATE OF KANSAS
STATE CORPORATION COMMISSIONGive All Information Completely
Make Required AffidavitMail or Deliver Report to:
Conservation Division
State Corporation Commission
800 Bittling Building
Wichita, Kansas

WELL PLUGGING RECORD

NORTH

Locate well correctly on above
Section Flat

Rush

County. Sec. 26 Twp. 19S Rge. (E) 16(W)

Location as "NE/CNW/SW" or footage from lines NW 1/4 - NW 1/4 - SW 1/4

Lease Owner Champlin Refining Company

Lease Name McKinney

Well No. 3

Office Address P. O. Drawer #552, Enid, Oklahoma.

Character of Well (completed as Oil, Gas or Dry Hole) Dry hole

Date well completed August 3, 19 49

Application for plugging filed October 17, 19 49

Application for plugging approved (Verbal) October 17, 19 49

Plugging commenced October 23, 19 49

Plugging completed October 30, 19 49

Reason for abandonment of well or producing formation.

If a producing well is abandoned, date of last production 19

Was permission obtained from the Conservation Division or its agents before plugging was commenced? Yes. Mr. C. D. Stough, Great Bend, Kansas.

Name of Conservation Agent who supervised plugging of this well Mr. C. D. Stough, Great Bend, Kansas.

Producing formation Depth to top Bottom Total Depth of Well 3775' Feet

Show depth and thickness of all water, oil and gas formations.

OIL, GAS OR WATER RECORDS

CASING RECORD

Formation	Content	From	To	Size	Put In	Pulled Out
				8 5/8" OD	1053'	None
				5 1/2" OD	3775'	2828' 10"

Describe in detail the manner in which the well was plugged, indicating where the mud fluid was placed and the method or methods used in introducing it into the hole. If cement or other plugs were used, state the character of same and depth placed, from feet to feet for each plug set.

Filled hole with heavy rock from 3775' to 3740' and set cement plug on top of rock using 5 sacks of cement, pumped plug down from top in surface casing using 100 sacks cement which filled hole to bottom of cellar

11-3-49
RECEIVED
NOV 3 1949
STATE CORPORATION
COMMISSION
KANSAS

(If additional description is necessary, use BACK of this sheet)

Correspondence regarding this well should be addressed to Champlin Refining Company
Address P. O. Drawer #552
Enid, Oklahoma.

STATE OF Kansas, COUNTY OF Barton, ss.
S. P. Hall (employee of owner) or (owner or operator) of the above-described well,
being first duly sworn on oath, says: That I have knowledge of the facts, statements, and matters herein contained and the log of the above-described well as filed and that the same are true and correct. So help me God.

(Signature) S. P. Hall

Box 167, Ellinwood, Kansas.

2nd. November 19 49

SUBSCRIBED AND SWORN to before me this day of

October 24, 1951

My commission expires

Notary Public.

22-5133-s

PLUGGING
FILE SEC 26 T 19 R 16 W

CHAMPLIN REFINING COMPANY

McKinney # 3


330' from north line, 330' from

West line of S.W. $\frac{1}{4}$ of Section 26-

19s-16w-

Rush County, Kansas

0'	- 110'	Shale & Sand
110'	- 460'	Shale, sand & shells
460'	- 485'	Shale
485'	- 595'	Sand
595'	- 645'	Shale
645'	- 740'	Shale, Lime & Sand Streaks
740'	- 1050'	Shale & Shells
1050'	- 1055'	Anhydrite
1055'	- 1136'	Shale & red beds
1136'	- 1555'	Shale
1555'	- 1800'	Shale & shells
1800'	- 1850'	Lime
1850'	- 2015'	Lime & shale
2015'	- 2150'	Lime, shale & sand
2150'	- 2270'	Lime & Shale
2270'	- 2340'	Lime & shale
2340'	- 2435'	Lime & shale
2435'	- 2500'	Shale & lime
2500'	- 2579'	Lime
2579'	- 2642'	Lime
2642'	- 2804'	Shale
2804'	- 2928'	Shale & lime
2928'	- 3040'	Lime Shale
3040'	- 3110'	Lime & shale
3110'	- 3156'	Broken lime
3156'	- 3215'	Lime & Shale
3215'	- 3270'	Lime & Shale
3270'	- 3318'	Lime
3318'	- 3359'	Lime
3359'	- 3423'	Lime
3423'	- 3454'	Lime
3454'	- 3505'	Lime
3505'	- 3548'	Lime
3548'	- 3573'	Lime
3573'	- 3600'	Lime
3600'	- 3637'	Lime & Chert
3637'	- 3676'	Lime
3676'	- 3714'	Lime
3714'	- 3756'	Lime
3756'	- 3773'	Lime
3773'	-	Total Depth

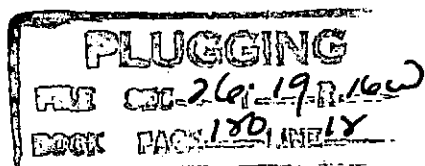

RECEIVED
 Conservation Div.
 OCT 18 1949