




640 Acres  
N

**WELL RECORD**

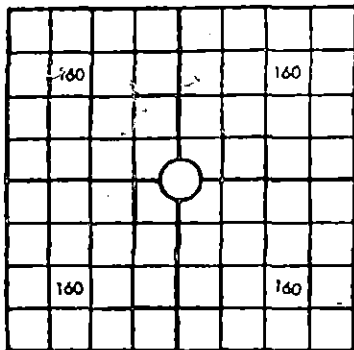

Locate Well Correctly

MAIL TO CORPORATION COMMISSION, OKLAHOMA CITY, OKLAHOMA  
 COUNTY McPherson, SEC. 29, TWP. 21S, RGE. 1W  
 COMPANY OPERATING Continental Oil Company  
 OFFICE ADDRESS Ponca City, Oklahoma  
 FARM NAME J. P. Huxman WELL NO. #6  
 DRILLING STARTED Dec. 28 19 37, DRILLING FINISHED Jan. 29, 19 38  
 DATE OF FIRST PRODUCTION 2-12-1938 COMPLETED \_\_\_\_\_  
 WELL LOCATED 330' South & 990' East of NW Corner of  
above section 1/4 ft. North of South  
 Line and \_\_\_\_\_ ft. East of West Line of Quarter Section.  
 Elevation (Relative to sea level) DERRICK FLOOR \_\_\_\_\_ GROUND 1485  
 CHARACTER OF WELL (Oil, gas or dry hole) Oil Well

OIL OR GAS SANDS OR ZONES

Name	From	To	Name	From	To
1 Wilcox Sand	3398	3418	4		
2 Hunton	3268	3320	5		
3			6		

WATER SANDS

Name	From	To	Water level	Name	From	To	Water level
1				4			
2				5			
3				6			

CASING RECORD

Size	Wt.	Thds.	Make	Amount Set		Amount Pulled			Packer Record		
				Ft.	In.	Ft.	In.	Size	Length	Depth Set	Make
10"				142'	-						
7"OD	20#	10		3411'	2						

Liner Record: Amount \_\_\_\_\_ Kind \_\_\_\_\_ Top \_\_\_\_\_ Bottom \_\_\_\_\_

CEMENTING AND MUDDING RECORD

Size	Amount Set		Sacks Cement	Chemical		Method of Cementing	Amount	Mudding Method	Results (See Note)
	Ft.	In.		Gal.	Make				
10	142	-	150			Halliburton			
7"OD	3411'	2	550			"			

NOTE: What method was used to protect sands when outer strings were pulled? \_\_\_\_\_

NOTE: Were bottom hole plugs used? \_\_\_\_\_ If so, state kind, depth set and results obtained \_\_\_\_\_

TOOLS USED

Rotary tools were used from 0 feet to 3389 feet, and from \_\_\_\_\_ feet to \_\_\_\_\_ feet to  
 Cable tools were used from 3389 feet to 3418 feet, and from \_\_\_\_\_ feet to \_\_\_\_\_ feet to  
 Type Rig \_\_\_\_\_

PRODUCTION DATA

Production first 24 hours 583 bbls. Gravity \_\_\_\_\_, Emulsion \_\_\_\_\_ per cent., Water \_\_\_\_\_ per cent  
 Production second 24 hours \_\_\_\_\_ bbls. Gravity \_\_\_\_\_, Emulsion \_\_\_\_\_ per cent., Water RECEIVED per cent  
 If gas well, cubic per 24 hours \_\_\_\_\_ Rock Pressure: lbs. per square inch \_\_\_\_\_

I, the undersigned, being first duly sworn upon oath, state that this well record is true, correct and complete according to the records of this office and to the best of my knowledge and belief.

90 Mill Dist - Supt  
 Name and title of representative of \_\_\_\_\_  
 STATE CORPORATION COMMISSION  
 RECEIVED  
 9 1937  
 WICHITA, KANSAS

Subscribed and sworn to before me this 18 day of February, 193 8.

My Commission expires \_\_\_\_\_

Notary Public.