

WELL PLUGGING RECORD

Give All Information Completely  
Make Required Affidavit  
Mail or Deliver Report to:  
Conservation Division  
State Corporation Commission  
211 No. Broadway  
Wichita, Kansas

McPherson County, Sec. 29 Twp. 21SRge. 16 (E) (W)

Location as "NE/CNW/SW" or footage from lines 1320' from S 2310' from E

Lease Owner Forbes Casing Pulling, Inc.

Lease Name A. K. Graber Well No. 5

Office Address P. O. Box 221 Great Bend, Kansas

Character of Well (completed as Oil, Gas or Dry Hole)

Date well completed 19

Application for plugging filed 3-13-61 19

Application for plugging approved 3-17-61 19

Plugging commenced 3-21-61 19


Plugging completed 3-23-61 19

Reason for abandonment of well or producing formation

Dry

If a producing well is abandoned, date of last production 19

Was permission obtained from the Conservation Division or its agents before plugging was commenced? Yes

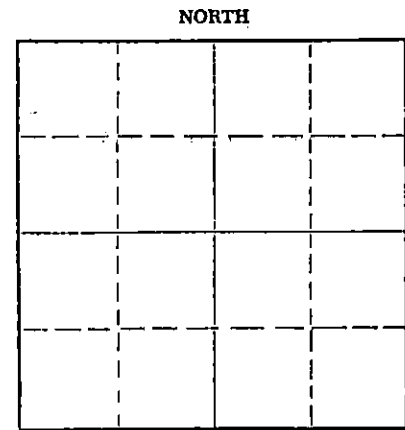

Locate well correctly on above Section Plat

Name of Conservation Agent who supervised plugging of this well Cecil M. Jones

Producing formation Depth to top Bottom Total Depth of Well 3319 Feet

Show depth and thickness of all water, oil and gas formations.

OIL, GAS OR WATER RECORDS

CASING RECORD

FORMATION	CONTENT	FROM	TO	SIZE	PUT IN	PULLED OUT
				10 3/4	119	None
				7	None	80 1/2

Describe in detail the manner in which the well was plugged, indicating where the mud fluid was placed and the method or methods used in introducing it into the hole. If cement or other plugs were used, state the character of same and depth placed, from feet to feet for each plug set.

Cleaned out cellar. Sanded to 3310'. Dumped 6 sacks of cement. Working pipe.

Shot pipe at 800'. Pulling pipe.

Build rock bridge at 160'. Dumped 3 yards of ready mix cement.

RECEIVED  
STATE CORPORATION COMMISSION

MAR 26 1964

3-26-64  
CONSERVATION DIVISION  
Wichita, Kansas

(If additional description is necessary, use BACK of this sheet)

Name of Plugging Contractor Forbes Casing Pulling, Inc.

Address P. O. Box 221 Great Bend, Kansas

STATE OF Kansas COUNTY OF Barton ss.  
J. O. Forbes

(employee of owner) or (owner or operator) of the above-described well, being first duly sworn on oath, says: That I have knowledge of the facts, statements, and matters herein contained and the log of the above-described well as filed and that the same are true and correct. So help me God.

(Signature) J. O. Forbes  
P. O. Box 221 Great Bend, Kansas  
(Address)

SUBSCRIBED AND SWORN TO before me this 25 day of March, 1964

My commission expires May 27, 1964

Notary Public.

15.113.04591.0000

DRILLERS LOGA. K. Graber No. 5

CASING RECORD:	COMPANY:	Continental Oil Company	DESCRIPTION:
10" @ 159' w/150 sacks cement	CONTRACTOR:		SE ¼ of Sec. 29-T21S- R1W, McPherson County, Kansas
7" OD @ 3293 w/300 sacks cement	COMMENCED:	April 4, 1938	ELEVATION: 1482' DF
TOTAL DEPTH: 3330'	COMPLETED:	April 27, 1938	

<u>FORMATION</u>	<u>FROM</u>	<u>TO</u>
Sand	0	20
Shale	20	60
Shale and Shells	60	158
Lime	158	159
Shale and Shells	159	346
Broken Lime	346	421
Shale and Shells	421	508
Broken Lime	508	841
Lime	841	916
Broken Lime	916	1000
Shale and Shells	1000	1695
Broken Lime	1695	1795
Shale and Shells	1795	1925
Broken Lime	1925	2025
Shale and Shells	2025	2075
Sandy Shale	2075	2220
Lime	2220	2771
Broken Lime	2771	2836
Shale	2836	2920
Chat	2920	2942
Chert	2942	2987
Chat	2987	3020
Lime	3020	3198
Dolomite	3198	3215
Lime	3215	3228
Shale	3228	3292
Hunton Lime	3292	3330

RECEIVED  
STATE CORPORATION COMMISSION

APR 7 1964

CONSERVATION DIVISION  
Wichita, Kansas