

STATE OF KANSAS
STATE CORPORATION COMMISSION

Form CP-4

Give All Information Completely
Make Required Affidavit
Mail or Deliver Report to:
Conservation Division
State Corporation Commission
212 No. Market
Wichita, Kansas

WELL PLUGGING RECORD

Rice County. Sec. 4 Twp. 21S Rge. 9W (E) (W)

Location as "NE/CNW/SW" or footage from lines. 150' SE of SE NE

Lease Owner Aspen Drilling Co.

Lease Name Vincent Well No. 1

Office Address P. O. Box 783, Great Bend, Kansas

Character of Well (completed as Oil, Gas or Dry Hole) Dry hole

Date well completed January 20 19 68

Application for plugging filed January 30 19 68

Application for plugging approved January 26 19 68


Plugging commenced January 20 19 68

Plugging completed same 19

Reason for abandonment of well or producing formation dry hole

If a producing well is abandoned, date of last production 19

Was permission obtained from the Conservation Division or its agents before plugging was commenced? YES

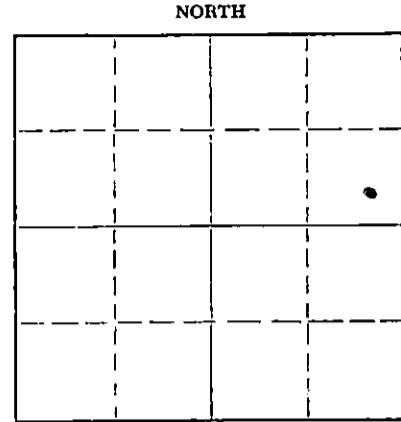

Locate well correctly on above Section Plat

Name of Conservation Agent who supervised plugging of this well Gilbert Toman

Producing formation Depth to top Bottom Total Depth of Well 3000 Feet

Show depth and thickness of all water, oil and gas formations.

OIL, GAS OR WATER RECORDS

CASING RECORD

FORMATION	CONTENT	FROM	TO	SIZE	PUT IN	PULLED OUT

Describe in detail the manner in which the well was plugged, indicating where the mud fluid was placed and the method or methods used in introducing it into the hole. If cement or other plugs were used, state the character of same and depth placed, from feet to feet for each plug set.

Mud to 200', wood plug, 1/4 sack hulls and 25 sacks cement.
Mud to 40', wood plug, 1/4 sack hulls and 10 sacks cement.
2 sacks cement in rat hole.

RECEIVED
STATE CORPORATION COMMISSION
FEB 16 1968
CONSERVATION DIVISION
Wichita, Kansas

2-16-68


(If additional description is necessary, use BACK of this sheet)
Name of Plugging Contractor Aspen Drilling Co.
Address P. O. Box 783, Great Bend, Kansas

STATE OF Kansas, COUNTY OF Barton, ss.

William S. Schachle (employee of owner) or (owner or operator) of the above-described well, being first duly sworn on oath, says: That I have knowledge of the facts, statements, and matters herein contained and the log of the above-described well as filed and that the same are true and correct. So help me God.

(Signature) William S. Schachle
P. O. Box 783, Great Bend, Kansas
(Address)

Subscribed and sworn to before me this 30th day of January, 19 68

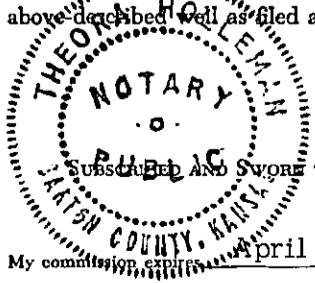

Theora Holleman Notary Public.

My commission expires April 18, 1968

DRILLERS LOG

COMPANY	Aspen Drilling Co.
CONTRACTOR	Aspen Drilling Co.
LEASE NAME	Vincent #1
LOCATION	150' SE of SE NE, Sec.4-T21S-R9W Rice County, Kansas
ELEVATION	G1. 1683 DF 1686
SURFACE CASING	5 jts.(201') 8 5/8"
COMMENCED	January 15, 1968
COMPLETED	January 20, 1968
ROTARY TOTAL DEPTH	3000'

<u>FORMATION</u>	<u>DEPTH</u>	
Anhydrite	289	Spudded 12 1/4" hole 1-15-68, ran 5 jts. (201') 8 5/8" set at 209'. Cemented with 200 sacks Sunset, cement circ.
Shale	1525	
Shale-Lime	1770	DST #1 2959-2980'
Shale	2530	
Shale-Lime	2658	D & A
Lime-Shale	2779	
Heebner	2784	
Lime	3000	
RTD	3000	

<u>FORMATION TOPS</u>	
Heebner	2777
Toronto	2799
Douglas	2808
Brown Lime	2911
Lansing	2940
Lansing 'B'	2965
Lansing 'D'	2986

AFFIDAVIT

STATE OF KANSAS)
) ss:
COUNTY OF BARTON)

The undersigned, being duly sworn on oath, states that the above statement and log are a true and correct record and log of the well drilled at the above described location..

William S. Schachle
William S. Schachle

Subscribed and sworn to before me this 30th day of January, 1968.

My Commission expires: April 18, 1968

Theora Holleman
Theora Holleman, Notary Public



RECEIVED
STATE CORPORATION COMMISSION
FEB 16 1968
CONSERVATION DIVISION
Wichita, Kansas