


STATE OF KANSAS  
STATE CORPORATION COMMISSION

WELL PLUGGING RECORD

Give All Information Completely  
Make Required Affidavit  
Mail or Deliver Report to:  
Conservation Division  
State Corporation Commission  
211 No. Broadway  
Wichita, Kansas

Rush County. Sec. 19 Twp. 17S Rge. 20 (E) W (W)  
Location as "NE/CNW/SW" or footage from lines G-SE-NW  
Lease Owner William H. Pine  
Lease Name Young Well No. 1  
Office Address Okmulgee, Oklahoma  
Character of Well (completed as Oil, Gas or Dry Hole) Dry Hole  
Date well completed December 3, 1966  
Application for plugging filed December 9, 1966  
Application for plugging approved \_\_\_\_\_ 19\_\_\_\_  
Plugging commenced December 3, 1966  
Plugging completed December 3 1966  
Reason for abandonment of well or producing formation no commercial shows of  
oil or gas

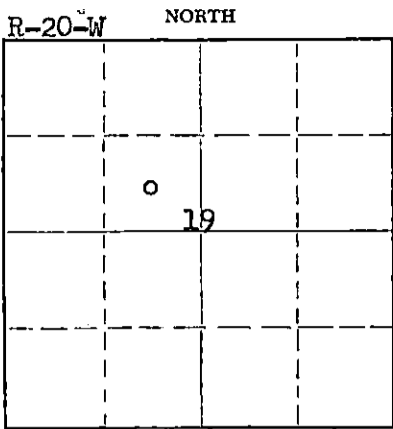

Locate well correctly on above  
Section Plat

If a producing well is abandoned, date of last production \_\_\_\_\_ 19\_\_\_\_  
Was permission obtained from the Conservation Division or its agents before plugging was commenced? Yes (Mr. L. F. Massey, Hays, Kansas)

Name of Conservation Agent who supervised plugging of this well Mr. L. F. Massey, Hays, Kansas  
Producing formation \_\_\_\_\_ Depth to top \_\_\_\_\_ Bottom \_\_\_\_\_ Total Depth of Well 4165 Feet  
Show depth and thickness of all water, oil and gas formations.

OIL, GAS OR WATER RECORDS

CASING RECORD

FORMATION	CONTENT	FROM	TO	SIZE	PUT IN	PULLED OUT
Surface Pipe		surface	272	8 5/8"	w/160sx cement	

Describe in detail the manner in which the well was plugged, indicating where the mud fluid was placed and the method or methods used in introducing it into the hole. If cement or other plugs were used, state the character of same and depth placed, from \_\_\_\_\_ feet to \_\_\_\_\_ feet for each plug set.

Plugged hole as follows; set plug @ 540' cemented with 25sx cement, filled w/mud to 260'; set plug and cemented w/20sx cement; filled with mud & hulls to 40'; cement w/8sx cement in top of surface casing. Last cement plug down @ 9:30pm December 3, 1966

RECEIVED  
STATE CORPORATION COMMISSION

DEC 10 1966

CONSERVATION DIVISION

(If additional description is necessary, use BACK of this sheet)

Name of Plugging Contractor Strata Drlg., Inc.  
Address Great Bend, Kansas

STATE OF OKLAHOMA, COUNTY OF OKMULGEE, ss.  
Dwayne H. Anderson (employee of owner) or (~~owner or operator~~) of the above-described well, being first duly sworn on oath, says: That I have knowledge of the facts, statements, and matters herein contained and the log of the above-described well as filed and that the same are true and correct. So help me God.

(Signature) Dwayne H. Anderson  
Okmulgee, Oklahoma  
(Address)

SUBSCRIBED AND SWORN TO before me this 9 day of December, 19 66

My commission expires 9-20-69

George Kelley  
George Kelley  
Notary Public.



DRILLERS LOG

#1 Young

CASING RECORD:  
266' of new 8-5/8"  
surface casing.

COMPANY: William H. Pine  
CONTRACTOR: Strata Drilling, Inc.

DESCRIPTION: C/SE NW  
Section 19-17S-20W  
Rush County, Kansas

TOTAL DEPTH:  
4165'

COMMENCED: November 23, 1966  
COMPLETED: December 3, 1966

D. & A.

<u>FORMATION</u>	<u>FROM</u>	<u>TO</u>	<u>REMARKS</u>
Surface Clay	0	281	Ran 266' of new 8-5/8" surface casing; set and cemented at 272' with 160 sacks of common sunset cement and 2% gel. Plug down at 5:40 A. M. November 24, 1966. Cement did not circulate.
Shale & Sand	281	1430	
Red Bed	1430	1459	
Anhydrite	1459	1480	
Shale & Shells	1480	1720	
Shale & Lime	1720	3483	
Lime	3483	4124	Ran two drill stem tests.
Sandy Lime	4124	4165	
Total Depth	4165'		Ran electric log.

D. & A.

Plugged hole as follows: Plugged at 540' with 25 sacks of cement; plugged at 260' with 20 sacks of cement; plugged at 40' with 6 sacks of cement. Plug down at 9:30 P. M. December 3, 1966.

RECEIVED  
CONSERVATION COMMISSION

DEC 12 1966

STATE OF KANSAS )  
                  ) SS.  
COUNTY OF BARTON)

CONSERVATION DIVISION  
Wichita, Kansas

I certify that this is a true and correct copy of the above log to the best of my knowledge.

STRATA DRILLING, INC.

*Jim B. McWilliams*  
Jim B. McWilliams, Secy-Treas.

Subscribed and sworn to before me this 6th day of December, 1966.

*Claine H. Taylor*  
Claine H. Taylor, Notary Public

My Commission Expires:

December 14, 1969