15-165-00269-00-00

STATE OF KANSAS
STATE CORPORATION COMMISSION

Give All Information Completely
Make Required Affidavit
Mail or Deliver Report to:
Conservation Division
State Corporation Commission
800 Bitting Building
Wichita, Kansas

WELL PLUGGING RECORD
OR
FORMATION PLUGGING RECORD

Strike out upper line when reporting plugging off formations.

NORTH

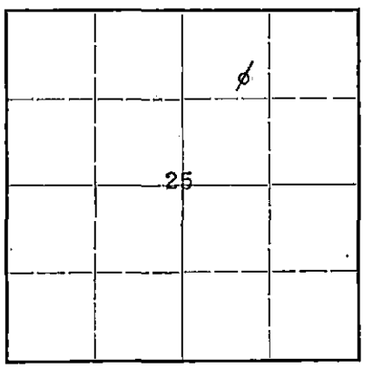

Locate well correctly on above Section Plat

Rush County. Sec. 25 Twp. 16S Rge. (E) 20 (W)

Location as "NE¼NW¼SW¼" or footage from lines SE NW NE

Lease Owner The Wolf Creek Oil Company

Lease Name Carman Well No. 1

Office Address 306 Fourth National Bank Bldg., Wichita, Kansas

Character of Well (completed as Oil, Gas or Dry Hole) Dry hole

Date well completed June 23, 1944

Application for plugging filed June 23, 1944

Application for plugging approved June 23, 1944

Plugging commenced June 23, 1944

Plugging completed June 23, 1944

Reason for abandonment of well or producing formation Dry

If a producing well is abandoned, date of last production 19

Was permission obtained from the Conservation Division or its agents before plugging was commenced? yes

Name of Conservation Agent who supervised plugging of this well Eldon R. Petty, Great Bend, Kansas

~~Producing~~ formation S.L. Arbuckle Depth to top 3862 Bottom Total Depth of Well 3962 Feet

Show depth and thickness of all water, oil and gas formations.

OIL, GAS OR WATER RECORDS

CASING RECORD

Formation	Content	From	To	Size	Put In	Pulled Out
				13-3/8" O.D.	127	cemented & left

Describe in detail the manner in which the well was plugged, indicating where the mud fluid was placed and the method or methods used in introducing it into the hold. If cement or other plugs were used, state the character of same and depth placed, from feet to feet for each plug set.

Hole was filled with Mud to base of surface pipe, 127'; then 50 sacks of cement were put in; hole then filled with mud to base of cellar and 15 sacks cement were put in.

PLUGGING
FILE 25-16-20W
BOOK PAGE 121 LINE 34

STATE CORPORATION COMMISSION
JUL 7 - 1944
CONSERVATION DIVISION

(If additional description is necessary, use BACK of this sheet)

Correspondence regarding this well should be addressed to The Wolf Creek Oil Company

Address 306 Fourth National Bank Building, Wichita, Kansas

STATE OF Kansas, COUNTY OF Sedgwick, ss.

O. E. Sutter (employee of owner) or (owner or operator) of the above-described well, being first duly sworn on oath, says: That I have knowledge of the facts, statements, and matters herein contained and the log of the above-described well as filed and that the same are true and correct. So help me God.

(Signature) O. E. Sutter Pres. & Gen. Mgr.

306 Fourth National Bank Bldg., Wichita, Ks.
(Address)

SUBSCRIBED AND SWORN TO before me this 5th day of July, 1944

Lorraine M. Johnson
Notary Public.

My commission expires January 27, 1947

20-1300-s 11-43—10M