


WELL PLUGGING RECORD

Give All Information Completely
Make Required Affidavit
Mail or Deliver Report to:
Conservation Division
State Corporation Commission
211 No. Broadway
Wichita, Kansas

Rush County. Sec. 3 Twp. 16S Rge. (E) 19 (W)

Location as "NE/CNW%SW%" or footage from lines C/SE NE
Lease Owner Donald C. Slawson
Lease Name Seelye Well No. A-1
Office Address 408 - One Twenty Building - Wichita, Kansas
Character of Well (completed as Oil, Gas or Dry Hole) Dry Hole
Date well completed 11-28 19 63
Application for plugging filed 11-28 19 63
Application for plugging approved 11-28 19 63
Plugging commenced 11-28 19 63
Plugging completed 11-28 19 63
Reason for abandonment of well or producing formation Dry Hole

NORTH

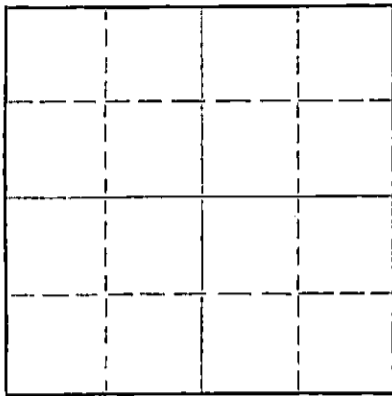

Locate well correctly on above
Section Plat

If a producing well is abandoned, date of last production _____ 19____
Was permission obtained from the Conservation Division or its agents before plugging was com-
menced? yes

Name of Conservation Agent who supervised plugging of this well Mr. Petty - Hays, Kansas
Producing formation _____ Depth to top _____ Bottom _____ Total Depth of Well 3622 Feet
Show depth and thickness of all water, oil and gas formations.

OIL, GAS OR WATER RECORDS

CASING RECORD

FORMATION	CONTENT	FROM	TO	SIZE	PUT IN	PULLED OUT

Describe in detail the manner in which the well was plugged, indicating where the mud fluid was placed and the method or methods used in introducing it into the hole. If cement or other plugs were used, state the character of same and depth placed, from _____ feet to _____ feet for each plug set.

1st plug @ 480' w/20 sacks
2nd plug @ 180' w/20 sacks
3rd plug @ 40' w/10 sacks

RECEIVED
STATE CORPORATION COMMISSION

DEC 26 1963

CONSERVATION DIVISION
Wichita, Kansas

(If additional description is necessary, use BACK of this sheet)

Name of Plugging Contractor Murfin Drilling Company
Address 617 Union Center - Wichita, Kansas

STATE OF Kansas, COUNTY OF Sedgwick, ss.
C. Robert Buford (employee of owner) or (~~owner~~) of the above-described well, being first duly sworn on oath, says: That I have knowledge of the facts, statements, and matters herein contained and the log of the above-described well as filed and that the same are true and correct. So help me God.

(Signature) C. Robert Buford
Murfin Drilling Company - 617 Union Center
(Address) Wichita, Kansas

SUBSCRIBED AND SWORN TO before me this 23rd day of December, 1963

ADELA MIZENER, Notary Public

My commission expires November 5, 1966

Notary Public.

WELL LOG

COMPANY **Donald C. Slawson**

SEC. **3** T. **16S** R. **19W**

FARM **Seelye** NO. **A-1**

LOC. **C/SE NE**


RIG. NO. **8**

TOTAL DEPTH **3634'**

COUNTRY **Rush - Kansas**
KANSAS

COMM. **11-17-63**

COMP. **11-28-63**

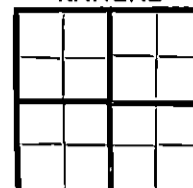

BHPT OR TREATED

CONTRACTOR **Murfin Drilling Company**

ISSUED

CASING

20	10
15	8 5/8" 1229' w/475 sx
12	6
13	5

ELEVATION

PRODUCTION **D & A**

FIGURES INDICATE BOTTOM OF FORMATIONS

- 100 Surface Clay
- 380 Shale
- 465 Sand - Shale
- 625 Shale
- 658 Sand & Shale
- 880 Sand
- 1216 Red Bed
- 1260 Anhydrite
- 1645 Shale & Shells
- 1850 Salt & Shale
- 2260 Shale & Lime
- 2705 Lime & Shale
- 3055 Shale & Lime
- 3280 Lime & Shale
- 3581 Lime
- 3616 Lime, Shale & Sand
- 3520 Sand & Lime
- 3634 Sand RTD

RECEIVED
STATE CORPORATION COMMISSION

DEC 26 1963

CONSERVATION DIVISION
Wichita, Kansas

State of Kansas }
 County of Sedgwick } ss:

I, C. Robert Buford of the Murfin Drilling Company

upon oath state that the above and foregoing is a true and correct copy of the log of the Seelye A-1 well.

C. Robert Buford
 C. Robert Buford

Subscribed and sworn to before me this 18th day of December 19 63

ADELA MIZENER, Notary Public
 My Commission Expires: My commission expires November 5, 1965

Adela Mizener
 NOTARY PUBLIC