


STATE OF KANSAS  
STATE CORPORATION COMMISSION  
CONSERVATION DIVISION  
P. O. BOX 17027  
WICHITA, KANSAS 67217

## WELL PLUGGING RECORD

NORTH

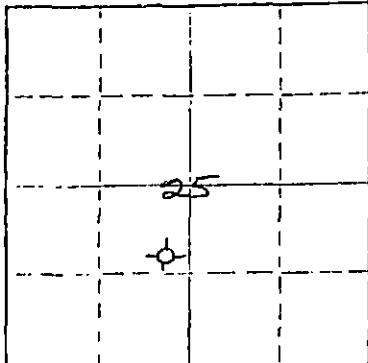

Locate well correctly on above  
Section Plat

Name of Conservation Agent who supervised plugging of this well Leo Massey  
Producing formation \_\_\_\_\_ Depth to top \_\_\_\_\_ Bottom \_\_\_\_\_ Total Depth of Well 3787 feet

Show depth and thickness of all water, oil and gas formations.

**OIL, GAS OR WATER RECORDS**

**OIL, GAS OR WATER RECORDS**

**CASING RECORD**

Describe in detail the manner in which the well was plugged, indicating where the mud fluid was placed and the method or methods used in introducing it into the hole. If cement or other plugs were used, state the character of same and depth placed, from surface feet to \_\_\_\_\_ feet for each plug set.

Well had 2" connection in top of 8 5/8". Pumped 300 sacks of common cement into casing. Well shut in with 500 psi on cement. Cut 8 5/8" casing off below ground level, filled to top with cement.

Name of Plugging Contractor NORTHERN NATURAL GAS CO. (If additional description is necessary, use BACK of this sheet)  
Address BOX 35288

STATE OF Oklahoma, COUNTY OF Woodward (employee of owner) or (owner  
will, being first duly sworn on oath, says: That I have knowledge of the facts, statements, and matters above-described well as filed and that the same are true and correct. So help me God. Charles W. Hickok  
(Signature) Charles W. Hickok


SUBSCRIBED AND SWEARN to before me this 24<sup>th</sup> day of August

My commission expires 7-30-82 July 30, 1982 July 30, 1982  
Xv13, Hathaway

RECEIVED  
STATE CORPORATION COMMISSION

SEP 05 1978

**CONSERVATION DIVISION**  
Wichita, Kansas

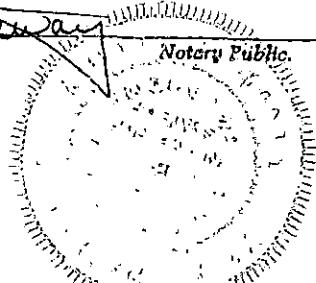

15.165.01791.00.00

CRESCENT OIL & GAS

#1 IDA SCHREIBER

25-18-18W

SE NE SW

Contr. DUKE-BURT

RUSH County

19850F Comm 10/1

Comp. 11/1/62


IP

D & A/ARB

LOG Tops	Depth	Datum
HEEB	3315	-1330
TOR	3332	-1347
LANS	3391	-1406
B/KC	3634	-1649
CONG	3712	-1727
ARB	3772	-1787
TD	3787	-1802

Casing  
8" 1108/650  
DST 3775-87/1 HR, 2490' SW, BHP  
1213-1213#, FP 141-1151#

UNNAMED POOL

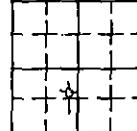

INDEPENDENT OIL & GAS SERVICE  
WICHITA, KANSAS