


STATE OF KANSAS
STATE CORPORATION COMMISSION
Give All Information Completely
Make Required Affidavit
Mail or Deliver Report to:
Conservation Division
State Corporation Commission
211 No. Broadway
Wichita, Kansas

WELL PLUGGING RECORD

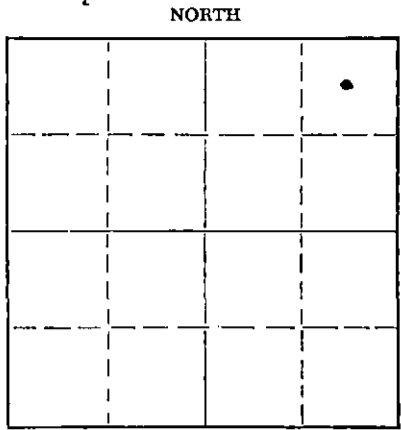

Locate well correctly on above Section Plat

Rush County. Sec. 28 Twp. 18 Rge. 16 ~~25~~ (W)
Location as "NE/CNW&SW" or footage from lines NE/4 NE/4 SE/4
Lease Owner Tuft-Weber-Francis
Lease Name Folkerts Well No. 1
Office Address Box 25, La Crosse, Kansas
Character of Well (completed as Oil, Gas or Dry Hole) Dry Hole
Date well completed 2/18/56 19
Application for plugging filed 2/18/56 19
Application for plugging approved 2/24/56 19
Plugging commenced 2/22/56 19
Plugging completed 2/22/56 19
Reason for abandonment of well or producing formation Dry Hole
If a producing well is abandoned, date of last production _____ 19
Was permission obtained from the Conservation Division or its agents before plugging was commenced? Yes

Name of Conservation Agent who supervised plugging of this well R. M. Brundage, Heisington, Kansas
Producing formation _____ Depth to top _____ Bottom _____ Total Depth of Well 3687 Feet
Show depth and thickness of all water, oil and gas formations.

OIL, GAS OR WATER RECORDS

CASING RECORD

FORMATION	CONTENT	FROM	TO	SIZE	PUT IN	PULLED OUT
		Surface	1080	8 5/8		remains
		Prod.		5 1/2	3727	3015.22

Describe in detail the manner in which the well was plugged, indicating where the mud fluid was placed and the method or methods used in introducing it into the hole. If cement or other plugs were used, state the character of same and depth placed, from _____ feet to _____ feet for each plug set.

Plugged from 3687 to 3658 with cement.
Plugged back with crushed rock from 3658 to 3640.
Dumped 5 sax cement at 3640 with dump bailer.
Top of cement 3610. Filled hole with mud to 300', set
rock bridge dumped 20 sax cement. Top of cement 240'.
Filled with mud to 35', set rock bridge, dumped 10 sax cement.

Completion date 2/22/56
State Plugger--R. M. Brundage
Heisington, Kansas


(If additional description is necessary, use BACK of this sheet)
Name of Plugging Contractor Miller Casing Pulling--Kansas Well Plugging License #12.
Address Great Bend, Kansas

STATE OF Kansas, COUNTY OF Rush, ss.
Vernon W. Weber (employee of owner) or (owner or operator) of the above-described well, being first duly sworn on oath, says: That I have knowledge of the facts, statements, and matters herein contained and the log of the above-described well as filed and that the same are true and correct. So help me God.

(Signature) [Signature]
Box 25, La Crosse, Kansas (Address)

SUBSCRIBED AND SWORN TO before me this 15 day of March, 19 56

My commission expires January 11, 1958 [Signature] Notary Public.

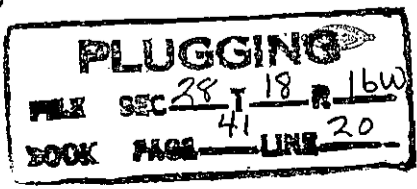

Clark Knight Drilling Company, Prod. Dept.
Great Bend, Kansas

Lease: Folkert
Well No: 1

Description:
NE NE SE 28-18-16W
Rush County, Kansas

Total Depth: 3687'

Elevation: 2020 R. B.
Production:

Comm: 1-23-56 Comp: 2-5-56
Contractor: Clark Knight Drilling Company
Rotary: 0-3687'

Casing Record: Set 8 5/8" @ 1080' - cemented with 540 sacks common with 2% cc -
cement circulated.

Formation tops:	
Clay and Post Rock	90'
Shale and Shells	375'
Sand and Shells	400'
Shale and Shells and iron pyrite	423'
Shale and Shells	475'
Sand	605'
Shale	640'
Sand	670'
Shale and Shells	1010'
Shale sand and Shells	1040'
Red rock and Clay	1065'
Clay shells and Sand	1075'
Anhydrite	1080'
Shale and Shells	1770'
Shale and Lime	1915'
Shale and Lime	2182'
Lime and Shale	2515'
Shale and Lime	2845'
Lime and Shale	3160'
Lime	3200'
Lime and Shale	3245'
Lime	3606'
Core #1 (Top sand 3634')	3637'
Core #2 Sand	3687'
Ream	3687'
Total Depth	3687'

We hereby certify this to be a correct and accurate log of the above described well as shown on the daily drilling reports

CLARK KNIGHT DRILLING COMPANY
Production Department

BY L. P. Knight

Subscribed and sworn to before me this 18th day of February 1956

My Commission Expires April 1, 1959

Ulanda Nichols
Ulanda Nichols - Notary Public

PLUGGING
FEB 28 1956
BOOK PAGE 41 LINE 20

RECEIVED
COMMISSION
FEB 20 1956
CONSERVATION DIVISION