


STATE OF KANSAS
STATE CORPORATION COMMISSION

Form CP-4

Give All Information Completely
Make Required Affidavit
Mail or Deliver Report to:
Conservation Division
State Corporation Commission
211 No. Broadway
Wichita, Kansas

WELL PLUGGING RECORD

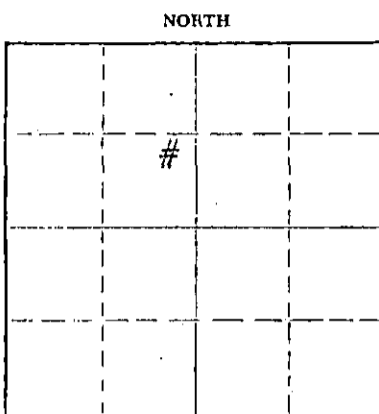

Locate well correctly on above
Section Plat

Rush County. Sec 27 Twp. 18 Rge. 16 (E) W (W)
Location as "NE/CNWxSWx" or footage from lines NE/SW/NE
Lease Owner Luft, Kerbs, & Francis
Lease Name Rodie Well No. B-3
Office Address Box 24 Great Bend, Ks.
Character of Well (completed as Oil, Gas or Dry Hole) Dry Hole
Date well completed Aug. 4, 1964
Application for plugging filed Nov. 9, 1964
Application for plugging approved Nov. 13, 1964
Plugging commenced Nov. 10, 1964
Plugging completed Nov. 12, 1964
Reason for abandonment of well or producing formation Dry hole.

If a producing well is abandoned, date of last production _____ 19____
Was permission obtained from the Conservation Division or its agents before plugging was commenced? Yes

Name of Conservation Agent who supervised plugging of this well Eldon Petty
Producing formation _____ Depth to top _____ Bottom _____ Total Depth of Well 3636 Feet
Show depth and thickness of all water, oil and gas formations.

OIL, GAS OR WATER RECORDS

CASING RECORD

FORMATION	CONTENT	FROM	TO	SIZE	PUT IN	PULLED OUT
				8 5/8	1057'	None
				5 1/2	3636'	3144'

Describe in detail the manner in which the well was plugged, indicating where the mud fluid was placed and the method or methods used in introducing it into the hole. If cement or other plugs were used, state the character of same and depth placed, from _____ feet to _____ feet for each plug set.

Plugged back with sand from 3636' to 3600'. Mixed and dumped #4 sx. of cement with dump bailer from 3600' to 3568'. Pulled casing. Mixed and pumped in 35 sx. of gel mud. Put in plug. Mixed and pumped in 100 sx. of cement from 300' to base of the cellar. 450 lbs. pumping pressure.

RECEIVED
STATE CORPORATION COMMISSION

DEC 4 1964

CONSERVATION DIVISION
Wichita, Kansas

(If additional description is necessary, use BACK of this sheet)

Name of Plugging Contractor Ace Pipe Pulling Co.
Address Box 304 Great Bend, Ks.

STATE OF Kansas, COUNTY OF Barton, ss.
R. W. Francis, partner & operator (employee of owner) or (owner or operator) of the above-described well, being first duly sworn on oath, says: That I have knowledge of the facts, statements, and matters herein contained and the log of the above-described well as filed and that the same are true and correct. So help me God.

(Signature) [Signature]
1710 Adams, Great Bend, Kansas
(Address)

SUBSCRIBED AND SWORN TO before me this 3rd day of December, 1964

My commission expires 4-27-65
[Signature] Notary Public.

