


STATE OF KANSAS
STATE CORPORATION COMMISSION

All Information Completely
Make Required Affidavit
Mail or Deliver Report to:
Conservation Division
State Corporation Commission
800 Biting Building
Wichita, Kansas

WELL PLUGGING RECORD

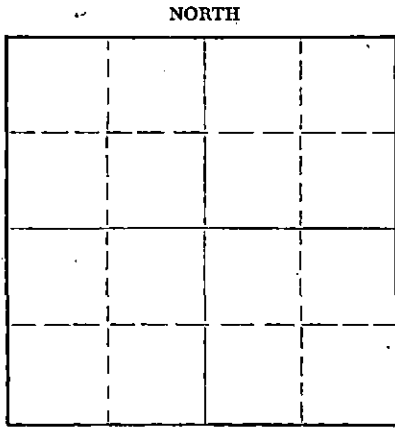

Locate well correctly on above
Section Plat

Rush County. Sec. 26 Twp. 18 Rge. 16 (X) (W)
Location as "NE/CNW/WSW" or footage from lines C-N/2-N/2-NE
Lease Owner Petroleum, Inc.
Lease Name SCHROEDER "A" Well No. 1
Office Address 311 East Third, Wichita, Kansas
Character of Well (completed as Oil, Gas or Dry Hole) Dry Hole
Date well completed April 27, 19 55
Application for plugging filed April 27, 19 55
Application for plugging approved April 27, 19 55
Plugging commenced April 27, 19 55
Plugging completed April 27, 19 55
Reason for abandonment of well or producing formation
Dry Hole

If a producing well is abandoned, date of last production 19
Was permission obtained from the Conservation Division or its agents before plugging was com-
menced? Yes

Name of Conservation Agent who supervised plugging of this well Mr. Warren Horner
Producing formation Depth to top Bottom Total Depth of Well 3628 Feet
Show depth and thickness of all water, oil and gas formations.

OIL, GAS OR WATER RECORDS

CASING RECORD

FORMATION	CONTENT	FROM	TO	SIZE	PUT IN	PULLED OUT
				8-5/8"	973'	None

Describe in detail the manner in which the well was plugged, indicating where the mud fluid was placed and the method or methods used in introducing it into the hole. If cement or other plugs were used, state the character of same and depth placed, from feet to feet for each plug set.

Mudded up to 300' and set first wooden
plug at 300'. Placed 1/3 sack of hulls on
top of plug. Displaced 20 sacks of cement through
drill pipe on top of hulls. Mudded up to 35' and
set second wooden plug at 35', 1/3 sack of hulls
on top of plug. Filled hole with 10 sacks of
cement to base of well cellar.

STATE CORPORATION COMMISSION
5-7-55
M.A.
CONSERVATION DIVISION

(If additional description is necessary, use BACK of this sheet)
Name of Plugging Contractor Garvey Drilling Company
Address R. R. #2 - Great Bend, Kansas

STATE OF KANSAS, COUNTY OF SEDGWICK, ss.
(employee of owner) or (owner or operator) of the above-described
well, being first duly sworn on oath, says: That I have knowledge of the facts, statements, and matters herein contained and the log of the
above-described well as filed and that the same are true and correct. So help me God.

(Signature) Karl E. Becker
311 East Third, Wichita, Kansas
(Address)

SUBSCRIBED AND SWORN TO before me this 2nd day of May, 19 55

My commission expires 8-11-58 Notary Public.

PLUGGING
FILE SEC 26 T 18 R 16W
BOOK PAGE 115 LINE 29

WELL LOG

15-165-01805.00.00

COMPANY **Petroleum, Inc.**

SEC. 26 T. 10S R. 16W

FARM **SCHROEDER "A"**

NO. 1

LOC. C 1/2 1/2 NE


TOTAL DEPTH **3628'**

COUNTY **Rush County, Kansas**

COMM. **April 15, 1955**

COMP. **April 27, 1955**

CONTRACTOR **Carvey Drilling Company**

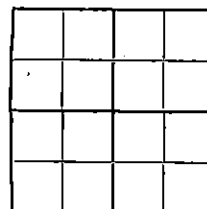

CASING **8-5/8" O 973' w/400 sax.**

ELEVATION **1931 RD**

PRODUCTION **D & A**

FIGURES INDICATE BOTTOM OF FORMATIONS

55	Clay and Sand	<u>Tops</u>
75	Shale	
340	Shale and Shells	Heebner: 3158 (-1227)
365	Hard Sand and Iron	Brown Lime: 3223 (-1292)
395	Shale	Lansing: 3233 (-1302)
630	Sand and Shale	Sand: 3476 (-1595)
964	Red Bed and Shells	
1015	Anhydrite	
1660	Shale and Shells	
2030	Lime and Shale	
2095	Lime	
3000	Lime and Shale	
3080	Lime	
3175	Lime and Shale	
3460	Lime	
3431	Lime and Shale	
3487	Core	
3508	Sand	
3539	Core	
3577	Sand	
3628	Sand and Shale	
R.T.D.	3628'	

RECEIVED
STATE CORPORATION COMMISSION

State of **KANSAS**

County of **SEDGWICK**

ss:

I, **Karl E. Becker**

of

Petroleum, Inc.

upon oath state that the above and foregoing is a true and correct copy of the log of the **SCHROEDER "A" #1** well.

Karl E. Becker

Subscribed and sworn to before me this **5th** day of **May**, 19**55**

My Commission Expires: **3-11-58**

PLUGGING

[Signature]

NOTARY PUBLIC

FILE SEC **26-18-R-16W**
BOOK PAGE **115** LINE **29**